

CERTIFIED RECORD OF LAND CORNER MONUMENTATION

V-17


History of original corner establishment:

Corner established by Henry W Cooke U.S. Deputy Surveyor under Contract No.427 dated December 15, 1881.

Surveyor General records state:

Set a basalt stone 12 x 12 x 12" 8" in ground for cor to sec 27, 26, 34 & 35 marked with 1 notch on S and 2 notches on E edges from which:

- A pine 14" dia bears N38°E, 28 lks dist marked T12SR36ES26 BT.
- A pine 38" dia bears S10°E, 78 lks dist marked T12SR36ES35 BT.
- A fir 10" dia bears S30°W, 91 lks dist marked T12SR36ES34 BT.
- A pine 36" dia bears N10°W, 80 lks dist marked T12SR36ES27 BT.

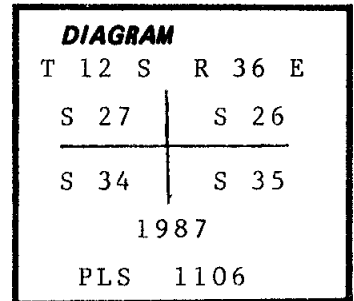

Description of corner evidence found:

A 12 x 12 x 6" basalt stone (record states 12 x 12 x 8") with 2 notches on S and 1 notch on E side in mound of stone from which:

A 20" p pine snag 8' high bears N38°E, 18.5' with scribing visible on double blaze. A down p pine stump bears S6°E (record S10°E), 51.5' with scribing visible on double blaze. A 24" fir bears S31°W (record S30°W), 59.4' with scribing visible on partially healed blaze. A 31" dead top p pine bears N13°W (record N10°W), 52.3' with scribing visible on partially healed double blaze.

Description of monument and accessories I established to perpetuate the original location of this corner:

At position of found original stone...

Set a 2½" x 30" aluminum pipe with 2½" aluminum cap 24" in the ground and surrounded with mound of earth and stone. Cap marked as shown in diagram. Buried corner stone in mound.

New bearing trees established from new monument:

- A 8" p pine bears N60°E, 68.9' scribed T12SR36ES26 BT.
- A 6" p pine bears S74°E, 72.0' scribed T12SR36ES35 BT.
- A 6" p pine bears N47½°W, 59.9' scribed T12SR36ES27 BT.

New bearing trees have a brass washer stamped PLS 1106 nailed to face of blaze, attached signs 54-3 & 54-9 and painted face of blaze and a 6" red band around each BT. Set steel fence post North of corner and attached sign 54-9. Original BT maintained to U.S.D.A.- Forest Service specifications. Compass declination 19° East.

I hereby certify that the above described corner monument was properly remonumented by me and witnessed by Bill Blanford on May 1, 1987.

**REGISTERED
PROFESSIONAL
LAND SURVEYOR**

William R. Wells

OREGON
JULY 22, 1977
WILLIAM R. WELLS
1106

Office of..... County Surveyor..... County of..... Baker.....
 State of..... Oregon....., I hereby certify that the within instrument was filed in this office
 for record on the..... day of....., 19.....
 by
 (COUNTY OFFICIAL) (DEPUTY)

FILED 6-3-87
 BAKER COUNTY SURVEYOR
 SURVEY NO. 12-36-19