

CERTIFIED RECORD OF LAND CORNER MONUMENTATION


X-13

History of original corner establishment:

Corner established by Henry W. Cooke U.S. Deputy Surveyor under Contract No.427 dated December 15, 1881.

Surveyor General records state:

Set a post 3½' long 3" square 2' in ground for 1/4 sec cor marked 1/4S on W face from which: A pine 36" dia bears S45°E, 73 lks dist marked 1/4S BT. A pine 16" dia bears S60°W, 52 lks dist marked 1/4S BT.

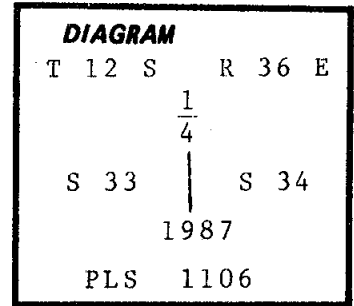

Description of corner evidence found:

A rotted post hole remains (soft spot) at ground level from which:
A 16" broken top p pine bears S56°W, 33.4' (record states S60°W) with scribing visible on burnt double blaze.
A 32" dead top p pine bears S41°E, 47.1' (record states S45°E) with scribing visible on burnt double blaze.

Description of monument and accessories established to perpetuate the original location of this corner:

At position of rotted post remains...

Set a 2½" x 30" aluminum pipe with 2½" aluminum cap 24" in the ground and surrounded with mound of earth and stone. Cap marked as shown in diagram.

New bearing trees established:

A 10" p pine bears N43½°E, 6.8' scribed 1/4S34 BT.
A 11" p pine bears N18½°W, 32.3' scribed 1/4S33 BT.

New bearing trees have a brass washer stamped PLS 1106 nailed to face of blaze, attached signs 54-3 & 54-9 and painted face of blaze and a 6" red band around each BT. Set steel fence post North of corner and attached sign 54-9.

Compass declination 19° East.

I hereby certify that the above described corner monument was properly remonumented by me and witnessed by Bill Blanford on May 1, 1987.

REGISTERED
PROFESSIONAL
LAND SURVEYOR

William R. Wells

OREGON
JULY 22, 1977
WILLIAM R. WELLS
1106

Office of.....County Surveyor..... County of..... Baker.....
State of..... Oregon....., I hereby certify that the within instrument was filed in this office
for record on the..... day of....., 19.....

..... by
(COUNTY OFFICIAL) (DEPUTY)

FILED 6-3-87
BAKER COUNTY SURVEYOR
SURVEY NO. 12-36-21