

CERTIFIED RECORD OF LAND CORNER MONUMENTATION


X-21

**History of original corner establishment:**

Corner established by Henry W. Cooke under Contract No. 427 and dated December 15, 1881.

Surveyor General records state:

Set a basalt stone 14 x 14 x 7 ins 10 ins in ground for 1/4 sec cor marked 1/4 on W face and raised a mound of stone alongside.

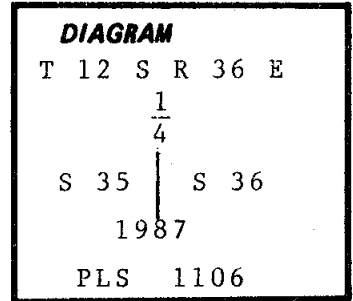

**Description of corner evidence found:**

Found a 14 x 11 x 7" (record 14 x 14 x 7") with "4" on W face, with a 2' diameter mound of stone on W side.

**Description of monument and accessories established to perpetuate the original location of this corner:**

At position of found original stone...

Set 2 1/2" aluminum pipe with 2 1/2" aluminum cap 12" in the ground and surrounded with a mound of earth and stone. Cap marked as shown in corner diagram. Buried corner stone alongside.

New bearing trees established:

The North stem of a double juniper 9" dia bears S21 1/2° E, 53.7' marked 1/4 S36 BT.

A 15" p pine bears S34 1/2° W, 114.1' marked 1/4 S35 BT.

New bearing trees have a brass washer stamped PLS 1106 nailed to face of blaze. Attached signs 54-3 & 54-9 and painted face of blaze and a 6" band around each BT. Set steel fence post North of corner and attached sign 54-9.

Compass declination 19° East.

I hereby certify that the above corner monument was properly re-established to U.S.F.S. standards under my supervision and witnessed by Bill Blanford on May 14, 1987.

REGISTERED PROFESSIONAL LAND SURVEYOR
---

*William R. Wells*

OREGON JULY 22, 1977 WILLIAM R. WELLS 1106
---

Office of... County Surveyor..... County of... Baker.....

State of... Oregon..... I hereby certify that the within instrument was filed in this office

for record on the..... day of....., 19.....

..... by .....

(COUNTY OFFICIAL)

(DEPUTY)

FILED 6-3-87  
 BAKER COUNTY SURVEYOR  
 SURVEY NO. 12-36-22