


CERTIFIED RECORD OF LAND CORNER MONUMENTATION

J-21

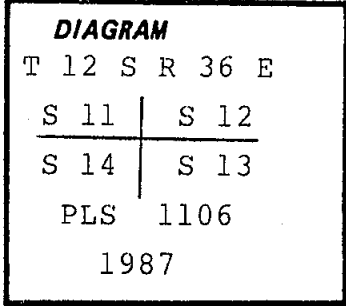

History of original corner establishment:

Corner established by Henry W. Cooke under Contract No. 427 and dated December 15, 1881.

Surveyor General records state:

Set a basalt stone 14 x 12 x 12 ins 10 ins in ground for cor to secs 11, 12, 13 & 14 marked with 4 notches on S and 1 notch on E edges from which:

- A pine 50 ins dia brs S40°E, 37 lks dist marked T12SR36ES13 BT.
- A pine 40 ins dia brs S32°W, 102 lks dist marked T12SR36ES14 BT.
- A pine 40 ins dia brs N35°W, 47 lks dist marked T12SR36ES11 BT.
- Dug pit 18 x 18 x 12 ins in sec 12 and raised a mound of earth alongside.

Description of corner evidence found:

Found basalt stone 14 x 11 x 10" (record, 14 x 12 x 12") firmly set with 4 notches on S face from which:

- Root hole brs S40°E, 24.4' dist.
- Root hole brs S32°W, 67.3' dist.
- Root hole brs N35°W, 31.0' dist. (remains of BTs found earlier are mostly destroyed by 1986 fire)

Description of monument and accessories established to perpetuate the original location of this corner:

At position of found original stone...



Set 2½" x 30" aluminum pipe with 2½" aluminum cap 24" in the ground, surrounded with mound of earth & stone. Cap marked as shown in corner diagram. Buried stone alongside.

No trees within limits, reference monuments established:
 Drove 30" rebar in ground brs N39°E, 9.4' with 1½" aluminum cap marked as shown beside:
 Drove 30" rebar in ground brs S60½°E, 9.8' with 1½" aluminum cap marked as shown beside:

Compass declination 19° East.

I hereby certify that the above corner monument was properly remonumented to U.S.F.S. standards under my supervision and witnessed by Scott Munro on May 27, 1987.

Ref. mons. are 5/8 by 30" rebar. Set steel fence post with sign 54-3 and 54-9 next to each R.M..

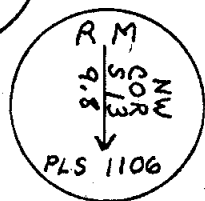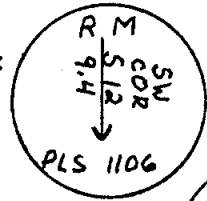

REGISTERED
PROFESSIONAL
LAND SURVEYOR

William R. Wells

OREGON
JULY 22, 1977
WILLIAM R. WELLS
1106

Office of County Surveyor..... County of Baker
 State of Oregon..... I hereby certify that the within instrument was filed in this office
 for record on the..... day of....., 19.....
 by
 (COUNTY OFFICIAL) (DEPUTY)