

CERTIFIED RECORD OF LAND CORNER MONUMENTATION


History of original corner establishment:

Corner established by Henry W. Cooke under Contract No. 427 and dated December 15, 1881.

Surveyor General records state:

Set basalt stone 10 x 10 x 10 ins 7 ins in ground for 1/4 on N face and raised a mound of stone alongside.

J-23

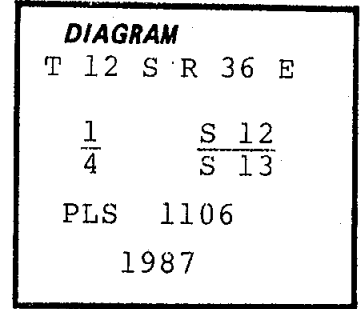

Description of corner evidence found:

Found basalt stone 11 x 9 x 7" (record, 10 x 10 x 10") firmly set, marked 1/4 on N face with stone mound alongside to North.

Description of monument and accessories established to perpetuate the original location of this corner:

At position of found original stone...

Set 2 1/2" x 30" aluminum pipe with 2 1/2" aluminum cap 20" in the ground, surrounded with mound of earth & stone. Cap marked as shown in corner diagram. Buried original stone alongside.

New bearing trees established:

P pine 14" dia brs N37 1/2° E, 23.0' marked 1/4 S12 BT.  
P pine 22" dia brs S12 1/2° E, 47.0' marked 1/4 S13 BT.

New bearing trees have a brass washer stamped PLS 1106 nailed to face of blaze. Attached signs 54-3 & 54-9 and painted face of blaze and a 6" band of red around each BT. Set steel fence post South of corner and attached sign 54-9.

Compass declination 19° East.

I hereby certify that the above corner monument was properly remonumented to U.S.F.S. standards under my supervision and witnessed by Scott Munro on May 27, 1987.

REGISTERED  
PROFESSIONAL  
LAND SURVEYOR

*William R. Wells*

OREGON  
JULY 22, 1977  
WILLIAM R. WELLS  
1106

Office of... County Surveyor..... County of... Baker.....  
State of... Oregon....., I hereby certify that the within instrument was filed in this office  
for record on the..... day of....., 19.....

..... by .....  
(COUNTY OFFICIAL) (DEPUTY)