

**CERTIFIED RECORD OF LAND CORNER MONUMENTATION**

N-13


**History of original corner establishment:**

Corner established by Henry W. Cooke under Contract No. 427 and dated December 15, 1881.

Surveyor General records state:

Set a basalt stone 14 x 14 x 10 ins 10 ins in ground with 3 notches on S and E edges from which:

A pine 36" dia bears S52°E, 119 lks dist marked T12SR36ES22 BT. A pine 36" dia bears S12°W, 137 lks dist marked T12SR36ES21 BT. No other trees within limits and raised a mound of stone alongside.

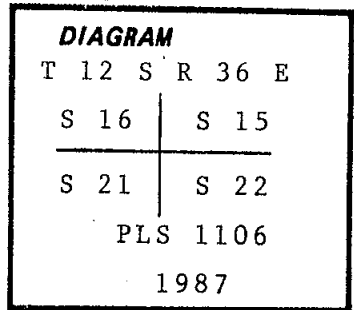

**Description of corner evidence found:**

From corner point established at record distance from 2 original BTs: (Stones are scattered Southeasterly down slope. Two are of near record size with no visible marks).

A p pine 29" dia bears S51°E (record S52°E), 78.5' with scribing visible on charred double blaze. A p pine snag 31" dia bears S12°W, 90.4' with scribing visible on charred double blaze.

**Description of monument and accessories established to perpetuate the original location of this corner:**

At position re-established from remaining original BTs...

Set 2½"x30" aluminum pipe with 2½" aluminum cap 21" in the ground and surrounded with a mound of earth and stone. Cap marked as shown in corner diagram.

New bearing trees established:

A p pine 12" dia bears S70½°W, 36.7' marked T12SR36ES21 BT.

A p pine 11" dia bears N69°W, 45.2' marked T12SR36ES16 BT.

A p pine 12" dia bears N18°E, 20.0' marked T12SR36ES15 BT.

New bearing trees have a brass washer stamped PLS 1106 nailed to face of blaze. Attached signs 54-3 & 54-9 and painted face of blaze and a 6" band around each BT. Set steel fence post South of corner and attached sign 54-9.

Compass declination 19° East.

I hereby certify that the above corner monument was properly remonumented to U.S.F.S. standards under my supervision and witnessed by Scott Munro on May 12, 1987.

**REGISTERED  
PROFESSIONAL  
LAND SURVEYOR**

*William R. Wells*

OREGON  
JULY 22, 1977  
WILLIAM R. WELLS  
1106

Office of..... County Surveyor..... County of..... Baker.....  
State of..... Oregon....., I hereby certify that the within instrument was filed in this office  
for record on the..... day of....., 19.....

..... by .....  
(COUNTY OFFICIAL) (DEPUTY)