

CERTIFIED RECORD OF LAND CORNER MONUMENTATION

T-25


History of original corner establishment:

Corner was originally established by Eugene P. Mc Cornack, U.S. Deputy Surveyor, under his Contract No. 398, dated July 2, 1881.

Surveyor General records state that at the corner a 14 by 12 by 5" basalt stone was set 10" in the ground, marked 1/4 on W. face from which:

A juniper, 8 ins. diam bears S10°W-40lks marked 1/4 S B.T.

No other trees within limits, raised a mound of stone alongside.

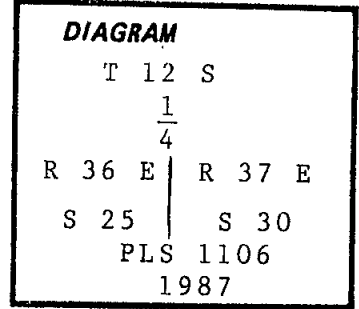

Description of corner evidence found:

A dead juniper 15" dia bears S10°W, 26.4' with scribing on chopped out blaze.

Description of monument and accessories established to perpetuate the original location of this corner:

At position re-established from remaining original BT....

Set 2½"x30" aluminum pipe with 2½" aluminum cap 18" in the ground and surrounded with a mound of earth and stone. Cap marked as shown in corner diagram.

New bearing trees established:

A juniper 14" dia bears N89°W, 38.0' marked 1/4S25 BT.

A juniper 11" dia bears S48½°E, 41.6' marked 1/4S30 BT.

New bearing trees have a brass washer stamped PLS 1106 nailed to face of blaze. Attached signs 54-3 & 54-9 and painted face of blaze and a 6" band around each BT. Set steel fence post West of corner and attached sign 54-9.

Compass declination 19° East.

I hereby certify that the above corner monument was properly remonumented to U.S.F.S. standards under my supervision and witnessed by Scott Munro on May 14, 1987.

REGISTERED PROFESSIONAL LAND SURVEYOR

William R. Wells

OREGON JULY 22, 1977 WILLIAM R. WELLS 1106

Office of.....County Surveyor..... County of..... Baker
State of..... Oregon....., I hereby certify that the within instrument was filed in this office
for record on the..... day of....., 19.....

..... by
(COUNTY OFFICIAL) (DEPUTY)