

CERTIFIED RECORD OF LAND CORNER MONUMENTATION

V-13


History of original corner establishment:

Corner established by Henry W. Cooke under Contract No. 427 and dated December 15, 1881.

Surveyor General records state:

Set a basalt stone 16 x 14 x 10 ins 11 ins in ground for cor to secs 27, 28, 33 & 34 marked with 1 notch on South and 3 notches on E edges from which:

- A pine 50" dia bears N28°E, 52 lks dist marked T 12SR36ES27 BT.
- A pine 14" dia bears S88°E, 74 lks dist marked T12SR36ES34 BT.
- A fir 24" dia bears S80°W, 25 lks dist marked T12SR36ES33 BT.
- A fir 16" dia bears N30°W, 68 lks dist marked T12SR36ES28 BT.

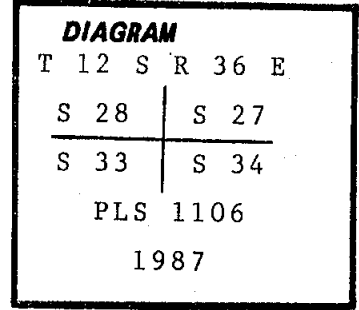

Description of corner evidence found:

Found a basalt stone 14 x 13 x 8" (record, 16 x 14 x 10") with no marks evident. Stone appears to have rolled downhill. (Set corner at record distance from 2 intact BTs)

P pine snag 37" bears N29¼°E (record, N28°E), 34.3' with BT scribing visible.

Dead and down fir with scribing visible, root hole bears S80°W, 16.5'.

P pine snag 16" bears S83¼°E (record, S88°E), 48.8' with scribing visible.

No evidence of other BT.

Description of monument and accessories established to perpetuate the original location of this corner:

At position re-established from remaining original BTs...

Set 2½"x30" aluminum pipe with 2½" aluminum cap 22" in the ground and surrounded with a mound of earth and stone. Cap marked as shown in corner diagram. Buried original stone alongside.

New bearing trees established:

Tamarack 9" dia bears N53½°E, 23.0' marked T12SR36ES27 BT.

D fir 13" dia bears S51°E, 58.8' marked T12SR36ES34 BT.

D fir 8" dia bears S32½°W, 27.2' marked T12SR36ES33 BT.

D fir 9" dia bears N6°W, 77.1' marked T12SR36ES28 BT.

New bearing trees have a brass washer stamped PLS 1106 nailed to face of blaze. Attached signs 54-3 and 54-9 and painted face of blaze and a 6" band of red around each BT. Set steel fence post South of corner and attached sign 54-9.

Compass declination 19° East.

I hereby certify that the above corner monument was properly remonumented to U.S.F.S. standards under my supervision and witnessed by Scott Munro on May 19, 1987.

REGISTERED PROFESSIONAL LAND SURVEYOR

William R. Wells

OREGON JULY 22, 1977 WILLIAM R. WELLS 1106

Office of...County...SURVEYOR..... County of...Baker.....
State of...Oregon....., I hereby certify that the within instrument was filed in this office
for record on the..... day of....., 19.....

..... by
(COUNTY OFFICIAL) (DEPUTY)