


CERTIFIED RECORD OF LAND CORNER MONUMENTATION

History of original corner establishment:

Corner was originally established by Eugene P. Mc Cornack, U.S. Deputy Surveyor, under his Contract No. 398, dated July 2, 1881.

Surveyor General records state: Set in ground for the corner to secs 25, 30, 31 and 36 marked with 5 notches on N and 1 notch on S edges and raised a mound of stone alongside. Pits impracticable.

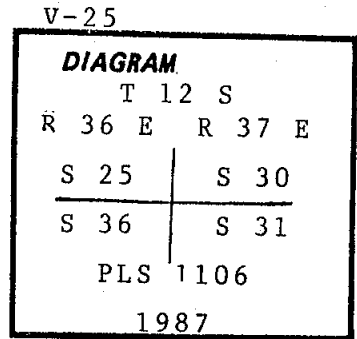

Description of corner evidence found:

Found basalt stone 18 x 10 x 5" with 5 notches on one face. (None apparent on other; in fence corner)


Description of monument and accessories I established to perpetuate the original location of this corner:

At position of found stone.....

Set 2 1/2"x30" aluminum pipe with 2 1/2" aluminum cap 22" in the ground and surrounded with a mound of earth and stone. Cap marked as shown in corner diagram. Buried corner stone alongside.

New bearing trees established:

A juniper 12" dia bears N35 3/4° E, 390.8' marked T12SR37ES30 BT.
 A juniper 16" dia bears S67 1/4° E, 332.2' marked T12SR37ES31 BT.
 A juniper 6" dia bears S21 3/4° W, 146.4' marked T12SR36ES36 BT.
 No BT available in S25...Set a reference monument 2' x 5/8" 20" in ground with 1 1/2" aluminum cap marked as shown bears N18 1/4° W, 10.6'dist.

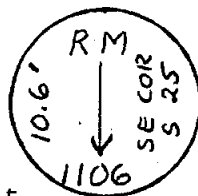

Note: Reference monument is a 5/8" by 2" rebar. New bearing trees have a brass washer stamped PLS 1106 nailed to face of blaze. Attached signs 54-3 & 54-9 and painted face of blaze and a 6" band around each BT. Set steel fence post South of corner and attached sign 54-9.

Compass declination 19° East.

I hereby certify that the above corner monument was properly remonumented to U.S.F.S. standards under my supervision and witnessed by Scott Munro on May 14, 1987.

**REGISTERED
PROFESSIONAL
LAND SURVEYOR**

William R. Wells

OREGON
JULY 22, 1977
WILLIAM R. WELLS
1106

Ref. monument has steel fence post set next to it with signs 54-3 and 54-9 attached.

Office of..... County Surveyor..... County of..... Baker
 State of..... Oregon..... I hereby certify that the within instrument was filed in this office
 for record on the..... day of....., 19.....
 by
 (COUNTY OFFICIAL) (DEPUTY)