

CERTIFIED RECORD OF LAND CORNER MONUMENTATION


X-17

**History of original corner establishment:**

Corner established by Henry W. Cooke under Contract No. 427 and dated December 15, 1881.

Surveyor General records state:

Set a basalt stone 14 x 10 x 10 ins 10 ins in ground for 1/4 sec cor marked 1/4 on W face, raised a mound of stone alongside.

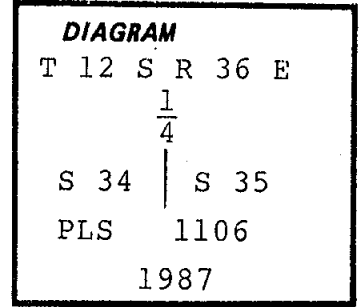

**Description of corner evidence found:**

Found basalt stone 16 x 11 x 7" (record, 14 x 10 x 10") marked 1/4.

**Description of monument and accessories established to perpetuate the original location of this corner:**

At position of found original stone...

Set 2 1/2" x 30" aluminum pipe with 2 1/2" aluminum cap 14" in the ground and surrounded with a mound of earth and stone. Cap marked as shown in corner diagram.

New bearing trees established:

A p pine 16" dia brs N35°W, 4.2' marked 1/4S34 BT.

A p pine 18" dia brs N57 1/4°E, 23.4' marked 1/4S35 BT.

New bearing trees have a brass washer stamped PLS 1106 nailed to face of blaze. Attached signs 54-3 & 54-9 and painted face of blaze and a 6" band of red around each BT. Set steel fence post West of corner and attached sign 54-9.

Compass declination 19° East.

I hereby certify that the above corner monument was properly established to U.S.F.S. standards under my supervision and witnessed by Scott Munro on May 30, 1987.

REGISTERED PROFESSIONAL LAND SURVEYOR
---

*William R. Wells*

OREGON JULY 22, 1977 WILLIAM R. WELLS 1106
---

Office of County Surveyor ..... County of Baker .....  
State of Oregon ..... I hereby certify that the within instrument was filed in this office  
for record on the ..... day of ..... , 19.....

..... by .....  
(COUNTY OFFICIAL) (DEPUTY)