

**CERTIFIED RECORD OF LAND CORNER MONUMENTATION**


N-25

**History of original corner establishment:**

Corner established by Eugene P. McCornack under Contract No. 398 and dated July 02, 1881.

Surveyor General records state:

Set post 4 ft long 4 ins square 27 ins in the ground for cor to secs 13, 18, 19 & 24 and marked T12ES18 on NE, R37ES19 on SE, R36ES24 on SW and S13 on NW faces with 3 notches on N and S edges from which:

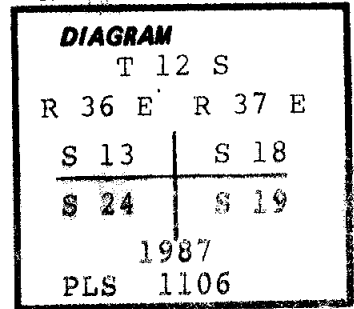

A pine 24 ins diam bears S42°E, 170 lks dist marked T12SR37ES19 BT. No other trees within limits, raised a mound of stone alongside.

**Description of corner evidence found:**

No evidence found after 3½ hours searching with 2 person crew on 3 separate occasions. The corner area and bearing tree area has been disturbed by spring development, ditch construction and pasture development.

**Description of monument and accessories established to perpetuate the original location of this corner:**

Re-established corner by single proportion measurement between found 1/4 13 | 18 and 24 | 19  
25 | 30...

Set 2½" x 30" aluminum pipe with 2½" aluminum cap 32" in the ground. Cap marked as shown in corner diagram. (Top of cap 2" below ground surface)

No BTs are available in NE quadrant which is mowed. Set RM in SE quadrant, along with marked BTs. Reference monument is a 5/8" x 30" rebar with 1½" aluminum cap marked as shown... bears S34°E, 16.9'. BTs: A 17" juniper brs S85°W, 203.3' scribed T12SR36ES24 BT. A 16" juniper brs N77½°W, 244.0' scribed T12SR36ES13 BT. A 25" p pine brs S18°E, 135.2' scribed T12SR37ES19 BT.



New bearing trees have a brass washer stamped PLS 1106 nailed to face of blaze. Attached signs 54-3 & 54-9 and painted face of blaze and a 6" band of red around each BT. Set steel fence post 5.0' South of corner and attached sign 54-9. Reference monuments have a steel fence post next to them and signs 54-3 and 54-9 attached.

Compass declination 19° East.

I hereby certify that the above corner monument was properly re-established to U.S.F.S. standards under my supervision and witnessed by Bill Blanford on June 19, 1987.

**REGISTERED  
PROFESSIONAL  
LAND SURVEYOR**

*William R. Wells*

OREGON  
JULY 22, 1987  
WILLIAM R. WELLS  
1106

Office of..... County Surveyor..... County of..... Baker  
Oregon  
State of....., I hereby certify that the within instrument was filed in this office  
for record on the..... day of....., 19.....  
..... by .....  
(COUNTY OFFICIAL) (DEPUTY)

FILED July 21, 1987  
BAKER COUNTY SURVEYOR  
SURVEY NO. 12-36-37