

CERTIFIED RECORD OF LAND CORNER MONUMENTATION


P-25

History of original corner establishment:

Corner established by Eugene P. McCornack under Contract No. 398 and dated July 02, 1881.

Surveyor General records state:

Set basalt stone 12 x 12 x 9 ins 8 ins in ground for 1/4 sec cor marked 1/4 on W face and raised a mound of stone alongside. Pits impracticable.

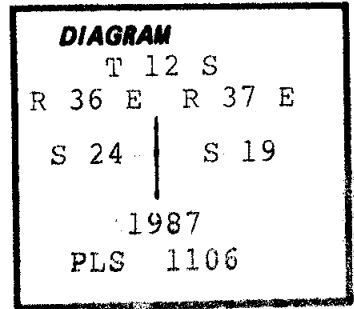

Description of corner evidence found:


None. Corner area falls in mowed pasture and original corner has been destroyed. Middle fork of Burnt River falls about 30' South of re-established corner point. Original topo call to Burnt River was not used in proportioning because river has undoubtedly moved and/or been rechanneled in development of pasture and irrigation system. Spent 1 hour with a 2 person crew searching for corner.

Description of monument and accessories established to perpetuate the original location of this corner:

Corner re-established by single proportion between $\frac{24}{25} \frac{19}{30}$ and $\frac{13}{24} \frac{18}{19}$, (re-established corner)...

Set 2 1/2" x 30" aluminum pipe with 2 1/2" aluminum cap 32" in the ground. Cap marked as shown in corner diagram. (Top of cap 2" below ground surface)

No suitable BTs within limits. Set two 5/8" x 30" rebar with 1 1/2" aluminum caps for reference monuments. A reference monument brs S37 1/2° E, 9.7' marked as shown... A reference monument brs S46 1/2° W, 13.1' marked as shown...

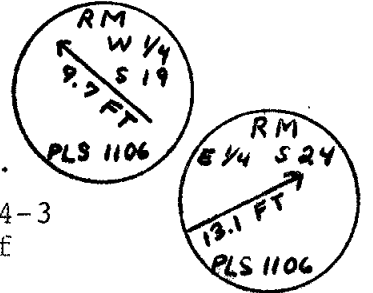

Reference monuments have a steel fence post with signs 54-3 and 54-9 next to them. Set steel fence post 3.0' South of corner and attached sign 54-9.

Compass declination 19° East.

I hereby certify that the above corner monument was properly re-established to U.S.F.S. standards under my supervision and witnessed by Bill Blanford on June 19, 1987.

REGISTERED PROFESSIONAL LAND SURVEYOR

Willi R. Wells

OREGON JULY 22, 1987 WILLIAM R. WELLS 1106

Office of.....County Surveyor..... County of.....Baker.....
State of.....Oregon....., I hereby certify that the within instrument was filed in this office
for record on the..... day of....., 19.....
..... by
(COUNTY OFFICIAL) (DEPUTY)

FILED July 21, 1987
BAKER COUNTY SURVEYOR
SURVEY NO. 12-36-40