


CERTIFIED RECORD OF LAND CORNER MONUMENTATION

R-16

History of original corner establishment:

None. Corner established with this survey.

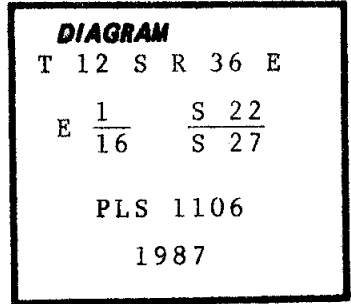

Description of corner evidence found:

None.

Description of monument and accessories established to perpetuate the original location of this corner:

At position established by survey...

Set 2½" aluminum pipe with 2½" aluminum cap 12" in the ground and surrounded with a mound of earth and stone. Cap marked as shown in corner diagram.

New bearing trees established:

A p pine 13" dia bears N31½°W, 37.8' marked E1/16S22 BT.

A p pine 14" dia bears S66°W, 22.7' marked E1/16S27 BT.

New bearing trees have a brass washer stamped PLS 1106 nailed to face of blaze. Attached signs 54-3 & 54-9 and painted face of blaze and a 6" band of red around each BT. Set steel fence post East of corner and attached sign 54-9.

Compass declination 19° East.

I hereby certify that the above corner monument was properly established to U.S.F.S. standards under my supervision and witnessed by Scott Munro on May 22, 1987.

REGISTERED PROFESSIONAL LAND SURVEYOR

William R. Wells

OREGON JULY 22, 1987 WILLIAM R. WELLS 1106

Office of...County...Surveyor..... County of...Baker.....

State of...Oregon....., I hereby certify that the within instrument was filed in this office for record on the..... day of....., 19.....

..... by
(COUNTY OFFICIAL) (DEPUTY)

FILED July 21, 1987
BAKER COUNTY SURVEYOR
SURVEY NO. 12-36-43