

CERTIFIED RECORD OF LAND CORNER MONUMENTATION


R-25

History of original corner establishment:

Corner established by Eugene P. McCornack under Contract No. 398 and dated July 02, 1881.

Surveyor General records state:

Set a post 4 ft long 4 ins square with marked stone 12 ins in ground for cor to secs 19, 24, 25 & 30 marked T12ES19 on NE, R36ES30 on SE, R36ES25 on SW and S24 on NW faces with 4 notches on N and 2 notches on S edges, dug pits 18 x 18 x 12 ins in each sec 5 1/2 feet dist and raised mound of earth 2 ft high 4 1/2 feet base around post.

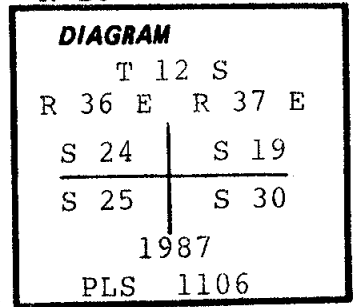

Description of corner evidence found:


None. This corner was searched for 1.0 hours with a 2 person crew. The original post and pits for the corner are long gone. Area is flooded in early spring. Fences have been built through area and a levee constructed immediately East of corner.

Description of monument and accessories established to perpetuate the original location of this corner:

Fences N-S and S80°W. Fence corner was accepted as best evidence of original corner location after tying corners South - North & West...

Set 2 1/2" x 30" aluminum pipe with 2 1/2" aluminum cap 24" in the ground, surrounded with mound of earth. Cap marked as shown in corner diagram.

No suitable BTs within limits. Set two 5/8" x 30" rebar with 1 1/2" aluminum caps for reference monuments. A reference monument brs N12°E, 22.5' marked as shown... A reference monument brs S82°W, 20.2' marked as shown... Reference monuments have a steel fence post with signs 54-3 and 54-9 next to them. Set steel fence post South of corner and attached sign 54-9.

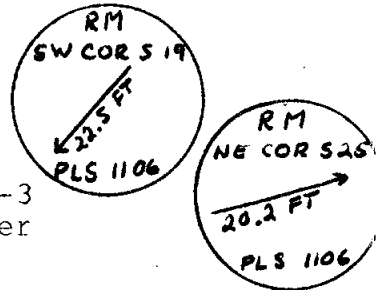

Compass declination 19° East.

I hereby certify that the above corner monument was properly re-established to U.S.F.S. standards under my supervision and witnessed by Bill Blanford on June 18, 1987.

REGISTERED
PROFESSIONAL
LAND SURVEYOR

Will R. Wells

OREGON
JULY 22, 1987
WILLIAM R. WELLS
1106

Office of.....County Surveyor..... County of.....Baker.....
State of.....Oregon....., I hereby certify that the within instrument was filed in this office
for record on the..... day of....., 19.....
..... by
(COUNTY OFFICIAL) (DEPUTY)

FILED July 21, 1987
BAKER COUNTY SURVEYOR
SURVEY NO. 12-36-46