


CERTIFIED RECORD OF LAND CORNER MONUMENTATION

T-19

**History of original corner establishment:**

None. Corner established with this survey.

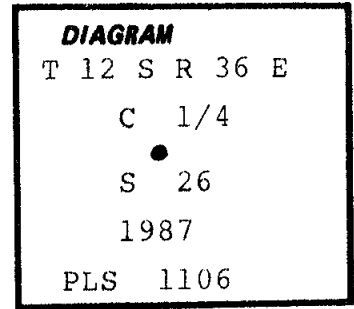

**Description of corner evidence found:**

None.

**Description of monument and accessories established to perpetuate the original location of this corner:**

At position established by survey...

Set 2 1/2" x 30" aluminum pipe with 2 1/2" aluminum cap 10" in the ground, surrounded with mound of earth & stone. Cap marked as shown in corner diagram.

**New bearing trees established:**

- A 8" juniper brs S41 1/2° E, 32.8' scribed C 1/4S26 BT.
- A 11" juniper brs N45° E, 49.6' scribed C 1/4S26 BT.

New bearing trees have a brass washer stamped PLS 1106 nailed to face of blaze. Attached signs 54-3 & 54-9 and painted face of blaze and a 6" band of red around each BT. Set steel fence post N.W. of corner and attached sign 54-9.

Compass declination 19° East.

I hereby certify that the above corner monument was properly established to U.S.F.S. standards under my supervision and witnessed by Bill Blanford on May 30, 1987.

REGISTERED PROFESSIONAL LAND SURVEYOR
---

*William R. Wells*

OREGON JULY 22, 1977 WILLIAM R. WELLS 1106
---

Office of.....County Surveyor..... County of.....Baker.....  
 State of.....Oregon....., I hereby certify that the within instrument was filed in this office  
 for record on the..... day of....., 19.....  
 ..... by .....  
 (COUNTY OFFICIAL) (DEPUTY)

FILED July 21, 1987  
 BAKER COUNTY SURVEYOR  
 SURVEY NO. 12-36-48