


CERTIFIED RECORD OF LAND CORNER MONUMENTATION

X-15

History of original corner establishment:

None. Corner established with this survey.

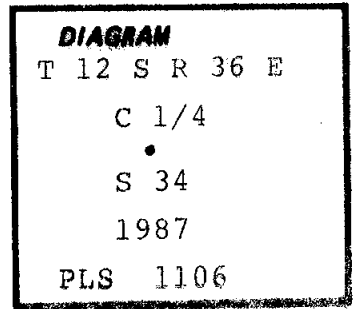

Description of corner evidence found:

None.

Note: A rock mound bears N75°E-15', origin unknown. Also, a alum. location poster is on a 18" doug. fir 10' SE of corner.

Description of monument and accessories I established to perpetuate the original location of this corner:

At position established by survey...

Set 2½" x 30" aluminum pipe with 2½" aluminum cap 14" in ground to bedrock surrounded with mound of earth & stone. Cap marked as shown in corner diagram.

New bearing trees established:

A 8" juniper brs N44½°E, 42.9' scribed C 1/4S34 BT.

A 10" p pine brs S10°E, 58.7' scribed C 1/4S34 BT.

New bearing trees have a brass washer stamped PLS 1106 nailed to face of blaze. Attached signs 54-3 & 54-9 and painted face of blaze and a 6" band of red around each BT. Set steel fence post alongside of corner and attached sign 54-9.

Compass declination 19° East.

I hereby certify that the above corner monument was properly established to U.S.F.S. standards under my supervision and witnessed by Bill Blanford on June 5, 1987.

REGISTERED PROFESSIONAL LAND SURVEYOR

William R. Wells

OREGON JULY 22, 1977 WILLIAM R. WELLS 1106

Office of..... County Surveyor..... County of..... Baker.....
 State of..... Oregon....., I hereby certify that the within instrument was filed in this office
 for record on the..... day of....., 19.....
 by
 (COUNTY OFFICIAL) (DEPUTY)

FILED July 21, 1987
 BAKER COUNTY SURVEYOR
 SURVEY NO. 12-36-50