


CERTIFIED RECORD OF LAND CORNER MONUMENTATION

X-16

History of original corner establishment:

None. Corner established with this Survey.

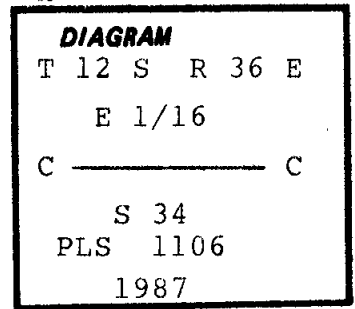

Description of corner evidence found:

None.

Description of monument and accessories I established to perpetuate the original location of this corner:

At position established by survey...

Set 2½" x 30" aluminum pipe with 2½" aluminum cap 16" in the ground and surrounded with a mound of earth and stone. Cap marked as shown in corner diagram.

New bearing trees established:

A p pine 14" dia brs N51°W, 8.0' marked CE 1/16S34 BT.

A p pine 15" dia brs S56°W, 52.5' marked CE 1/16S34 BT.

New bearing trees have a brass washer stamped PLS 1106 nailed to face of blaze. Attached signs 54-3 & 54-9 and painted face of blaze and a 6" band of red around each BT. Set steel fence post South of corner and attached sign 54-9.

Compass declination 19° East.

I hereby certify that the above corner monument was properly established to U.S.F.S. standards under my supervision and witnessed by Scott Munro on May 30, 1987.

REGISTERED PROFESSIONAL LAND SURVEYOR

William R. Wells

OREGON JULY 22, 1977 WILLIAM R. WELLS 1106

Office of...County Surveyor..... County of...Baker.....
State of...Oregon....., I hereby certify that the within instrument was filed in this office
for record on the..... day of....., 19.....

..... by
(COUNTY OFFICIAL) (DEPUTY)

FILED July 21, 1987
BAKER COUNTY SURVEYOR
SURVEY NO. 12-36-51