

CORNER RESTORATION FORM

Township 12S Range 37E Section 18 County BAKER

State OREGON Date 6/16/08 Number N-01

Corner Designation : SW corner Sec. 18

- Condition Report Only
- Not Found
- Renewed
- Surveyed In
- Referenced

Previous Renewals

Monument (s) Found: (Condition and Source)

The corner was originally established by E.P. McCormack under Contract No. 398, dated August 15, 1881. McCormack's field notes indicate he set a "post 4 ft. long 4 ins. square 24 ins. in the ground for cor. to sec.'s 13, 18, 19 and 24, marked with T12S S18 on NE, R37E S19 on SE, R36E S24 on SW, and S13 on NW faces with 3 notches on N and S edges. From which a pine 24 ins. diam. bears S42°E 170 lks dist. marked T12SR37ES19 BT. No other trees within limits. Raised a mound of stone alongside." Original monument not found.

Found an 2½" aluminum cap on an aluminum post per Baker County Survey No. 12-37-18.


Accessories Found:

- Bearing Trees with aluminum Forest Service signs bear:
- 1) S18°E 135.2 ft., a 30"Ø pine/fir
 - 2) N77½°W 244.0 ft., a 22"Ø juniper
 - 3) S85°W 203.3 ft., a 20"Ø juniper

A found witness monument, an aluminum cap on rebar stamped:
"RM NW COR. S.19 16.9 FT. PLS1106"
bears: SE 16.99 ft

MONUMENT DETAIL

Found Set

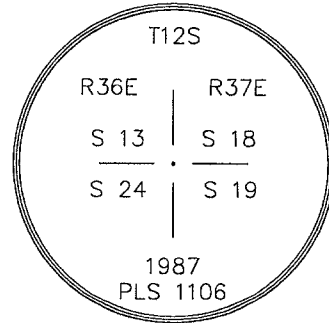

Monument & Accessories Set (Procedure and Description)

No new accessories were set

<p>Sketch of Monument, Accessories and General Area</p> <div style="text-align: right; margin-bottom: 10px;"> </div> <div style="display: flex; justify-content: space-between;"> <div style="width: 45%;"> <p>BT, 22" JUNIPER w/FOREST SERVICE SIGNS, N77½°W 244.0 FT.</p> </div> <div style="width: 45%; text-align: center;"> <p>N-01, SW COR. SEC. 18 FD. 2½" AL. CAP MON.</p> </div> </div> <div style="display: flex; justify-content: space-between; margin-top: 20px;"> <div style="width: 45%;"> <p>BT, 20" JUNIPER w/FOREST SERVICE SIGNS, N85°E 203.3 FT.</p> </div> <div style="width: 45%; text-align: center;"> <p>WITNESS MONUMENT AL. CAP ON REBAR SE 16.99 FT.</p> </div> </div> <div style="text-align: center; margin-top: 20px;"> <p>BT, 30" PINE/FIR w/FOREST SERVICE SIGNS, S18°E 135.2 FT.</p> </div>	<div style="text-align: center; border: 1px solid black; padding: 5px; margin-bottom: 5px;"> <p>Surveyor's Seal</p> <p>REGISTERED PROFESSIONAL LAND SURVEYOR</p> <p><i>Dean J. Coon</i> 6/16/08</p> <p>OREGON JANUARY 8, 2002 DEAN J. COON 65687LS</p> </div> <div style="border: 1px solid black; padding: 5px; margin-bottom: 5px;"> <p>RENEWAL DATE: 12/31/09</p> </div> <p>Agency <u>HOLLADAY ENGR. CO.</u> <u>32 N. MAIN ST.</u> <u>PAYETTE, ID 83661</u></p> <p>Party Chief <u>D. COON</u></p> <p>Notekeeper <u>D. COON</u></p> <p>Job No. <u>PR08024</u></p> <p>Field Book <u>LL, pg. 2</u></p> <p>Date of Work <u>5/22/08</u></p> <div style="border: 1px solid black; padding: 5px; margin-top: 5px;"> <p style="text-align: center;">COUNTY SURVEYOR RECORDING INFO</p> <p>Received <u>6-18-2008</u></p> <p>Accepted <u>12-36-65</u></p> <p>Survey No. <u>12-37-79</u></p> <p>Drawing No. _____</p> <p>Index No. _____</p> </div>
---	---