


CERTIFIED RECORD OF LAND CORNER MONUMENTATION

HISTORY OF ORIGINAL CORNER ESTABLISHMENT:

THIS CORNER WAS ORIGINALLY ESTABLISHED BY EUGENE P. McCORNACK UNDER CONTRACT NO. 398 DATED JULY 2, 1881.

SURVEYOR GENERAL LAND OFFICE RECORDS STATE:
 "SET BASALT STONE 12"X10"X10", 8" IN GROUND FOR THE CORNER TO TOWNSHIPS 12 AND 13S, R36 AND 37E, MARKED WITH 6 NOTCHES ON EACH EDGE AND RAISED A MOUND OF STONE ALONGSIDE. PITS IMPRACTICABLE"

DIAGRAM

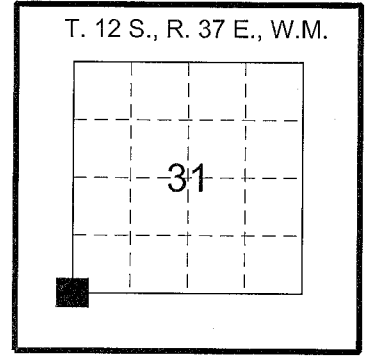

Z-1

DESCRIPTION OF CORNER EVIDENCE FOUND:

FOUND 14"X11"X10" STONE MARKED WITH 6 NOTCHES ON EACH EDGE, LYING ON ITS SIDE IN A MOUND OF STONES.


DESCRIPTION OF MONUMENT AND ACCESSORIES I ESTABLISHED TO PERPETUATE THE ORIGINAL LOCATION OF THIS CORNER:

RE-ESTABLISHED THE CORNER BY REPLACING EXISTING STONE IN THE SAME POSITION AS IT WAS RECOVERED.

SET 2-1/2" BRASS CAP ON A 3/4" INSIDE DIAMETER X 30" IRON PIPE FLARED AT THE BOTTOM, SURROUNDED BY MOUND OF STONES, WITH THE ORIGINAL STONE BURIED BESIDE, AND A POST WITH PADDLE SET ALONGSIDE.
 THE CAP IS MARKED AS SHOWN BELOW.

THE REFERENCES SET FOR SAID CORNER ARE AS FOLLOWS:

- 1) A 5/8" X 30" IRON ROD WITH A 1-1/2" ALUMINUM CAP, FLUSH, STAMPED "ODOT" BEARS S3°12'54"W, 54.61 FEET.
- 2) A 5/8" X 30" IRON ROD WITH A 1-1/2" ALUMINUM CAP, UP 5", STAMPED "ODOT" BEARS S63°03'05"W, 74.21 FEET.
- 3) A PINK DEEPI MAGNET BURIED 6" BELOW THE GROUND BEARS N49°45'10"W, 64.56 FEET.
- 4) A BLUE DEEPI MAGNET BURIED 6" BELOW THE GROUND BEARS N21°23'48"E, 46.26 FEET.

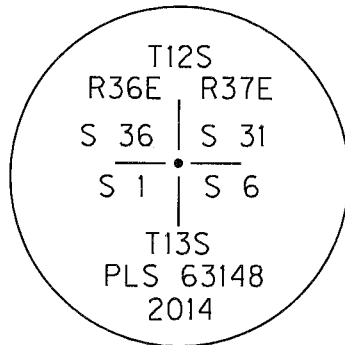

WITNESSES:
 BRET ELITHORP, PLS
 MARK STEWART, CODY WHEELER

I HEREBY CERTIFY THAT THE ABOVE CORNER POSITION WAS RE-ESTABLISHED AS HEREON DESCRIBED ON OCTOBER 1, 2014.

FILED Dec. 19, 2014

BAKER COUNTY SURVEYOR

SURVEY NO. 12-36-68/12-37-91

REGISTERED
 PROFESSIONAL
 LAND SURVEYOR

B. N. Elithorp

OREGON
 JAN 14, 2003
 BRET N. ELITHORP
 61348

RENEWS: 12/31/2015

OREGON DEPARTMENT OF TRANSPORTATION



| | | | |
|---------|------------------|-------|---------------|
| Section | CEMETERY QUARRY | | |
| Highway | JOHN DAY HIGHWAY | | |
| County | BAKER | Scale | NTS |
| Purpose | QUARRY BOUNDARY | Date | OCT. 20, 2014 |