

CERTIFIED RECORD OF LAND CORNER MONUMENTATION


History of original corner establishment:

Corner established under G L O contract number 409, dated March 28, 1882, by William R. Gradon.

Set a basalt stone 24 x 12 x 10 ins. 18 ins. in the ground for cor. to secs. 22, 23, 26 and 27 marked with 2 notches on S. and E. edges from which:

A pine 12 ins. dia. bears N 75° E., 94 lks. dist. marked T 12 S R 37 E S 23 BT

No other trees within limits and raised a mound of stone alongside.

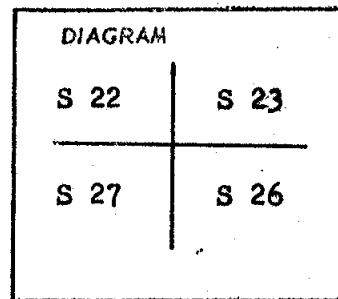

Description of corner evidence found:

Found stone in rock mound one foot south of fence line which runs east and west.

Found a pine 24 ins. dia. which bears N 75° E 62 feet dist. (94 lks) with a healed blaze.

Description of monument and accessories established to perpetuate the original location of this corner

Set a 1 in. iron pipe with a 2½ in. brass cap at corner point and buried stone alongside marked thus:

T 12 S R 37 E

S 22	S 23
S 27	S 26

 C S 1977

Office of County Surveyor County of Baker
 State of Oregon, I hereby certify that the within instrument was filed in this office
 for record on the 3 day of May 1977
 By Bill Hanley
(COUNTY OFFICIAL) (DEPUTY)

FILED MAY 3, 1977
 BAKER COUNTY SURVEYOR
 SURVEY NO. 12-37-5

