


CERTIFIED RECORD OF LAND CORNER MONUMENTATION

History of original corner establishment:

Corner was established by Eugene P. McCornack under GLO Contract No. 398, dated July 2, 1881. Notes of that survey state: "Set a basalt stone 18 x 8 x 6 ins. 12 ins. in the ground for 1/4 sec. cor. marked 1/4 on W face and raised a mound of stones alongside. Pits impracticable."

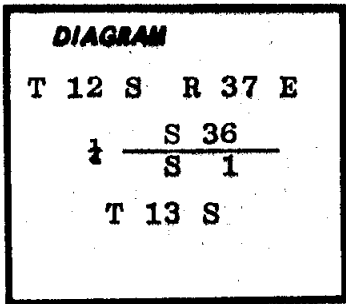


Description of corner evidence found:

Properly marked 17 x 10 x 4 ins. stone and stone mound along the North side.

Description of monument and accessories established to perpetuate the original location of this corner:

Set a 2 1/2-inch brass cap on 1-inch ID steel pipe x 30 ins. long, extending 5 inches above the ground in a 3-ft. diam. stone mound. Buried stone 1 ft. North. Set USFS 54-9 tag on steel fence post 4 ft. West. Monument is marked thus:

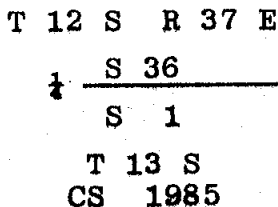

Monument was set October 25, 1985, witnessed by Tom Fisk and Larry McBrook

**REGISTERED
PROFESSIONAL
LAND SURVEYOR**

James D. Hanley
**OREGON
SEPTEMBER 23, 1977
JAMES D. HANLEY
1206**

Office of..... **County Surveyor** County of..... **Baker**
State of..... **Oregon**, I hereby certify that the within instrument was filed in this office
for record on the..... **30** day of..... **Oct.**, 19..... **85**
..... by
(COUNTY OFFICIAL) (DEPUTY)