

CERTIFIED RECORD OF LAND CORNER MONUMENTATION


E-13

History of original corner establishment:

Corner established by William R. Gradon under Contract No. 409 dated March 28, 1882.

Surveyor General records state:

Set a basalt stone 14 x 10 x 10 ins 10 ins in ground for cor to secs 3, 4, 9 & 10 marked with 5 notches on S and 3 notches on E edges and raised a mound of stone 2 ft high 5½ ft base alongside.

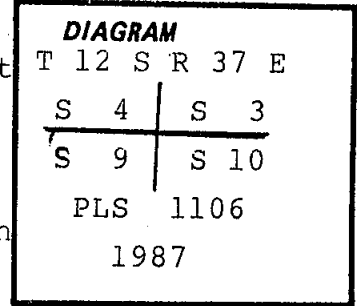

Description of corner evidence found:


Found a basalt stone 14 x 8 x 7" (record, 14 x 10 x 10") firmly set with 5 notches on S side and 3 notches on E side in mound of stone.

Description of monument and accessories established to perpetuate the original location of this corner:

At position of found stone...

Set 2½" x 30" aluminum pipe with 2½" aluminum cap 20" in the ground and surrounded with a mound of earth and stone. Cap marked as shown in corner diagram.

New bearing trees and reference monuments established:
 Juniper 16" dia S50°E, 84.9' mkd T12SR37ES10 BT.
 Juniper 19" dia N43 ¾°W, 157.5' mkd T12SR37ES4 BT.
 At N13 ¾°E, 8.0' drove 30"x5/8" rebar 25" in ground with 1½" aluminum cap mkd as shown beside:
 At S57°W, 5.4' drove 30"x5/8" rebar 26" in ground with 1½" aluminum cap mkd as shown beside:

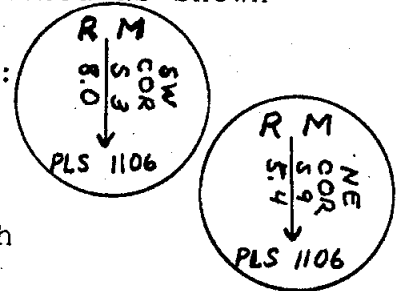

New bearing trees have a brass washer stamped PLS 1106 nailed to face of blaze. Attached signs 54-3 & 54-9 and painted face of blaze and a 6" band of red around each BT. Set steel fence post West of corner and attached sign 54-9. Set steel fence post with signs 54-9 and 54-3 attached next to each reference monument.

Compass declination 19° East.

I hereby certify that the above corner monument was properly established to U.S.F.S. standards under my supervision and witnessed by Scott Munro on May 29, 1987.

**REGISTERED
PROFESSIONAL
LAND SURVEYOR**

William R. Wells

OREGON
JULY 22, 1977
WILLIAM R. WELLS
1106

Office of...County...Surveyor..... County of...Baker.....
 State of...Oregon..... I hereby certify that the within instrument was filed in this office
 for record on the..... day of....., 19.....

..... by
 (COUNTY OFFICIAL) (DEPUTY)