

CERTIFIED RECORD OF LAND CORNER MONUMENTATION

E-7

History of original corner establishment:


Corner established by William R. Gradon under Contract No. 409 dated March 28, 1882.

Surveyor General records state:

Set a basalt stone 16 x 16 x 8 ins 11 ins in ground for 1/4 sec cor marked 1/4 on N face from which:

A fir 20 ins dia bears N38°E, 32 lks dist marked 1/4S BT.

A pine 12 ins dia bears S10°W, 70 lks dist marked 1/4S BT.

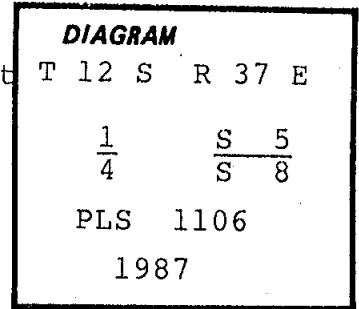

Description of corner evidence found:

Found a 6' steel fence post set in mound of stone, found basalt stone 19 x 15 x 6" (record, 16 x 16 x 8") very rough and no marks evident from which:

A fir stump about 24" dia brs N54°E (record N38°E), 21.1' with scribing visible.

A p pine 20" dia brs S15°W (record, S10°W), 46.2' with scribing obliterated by axe work.

Description of monument and accessories I established to perpetuate the original location of this corner:

At position of found stone...

Set 2 1/2" x 30" aluminum pipe with 2 1/2" aluminum cap 24" in the ground, surrounded with mound of earth & stone. Cap marked as shown in corner diagram.

New bearing trees established:

A p pine 6" dia brs S4 1/2°E, 80.2' marked 1/4S8 BT.

A p pine 11" dia brs N36 1/2°W, 35.2' marked 1/4S5 BT.

New bearing trees have a brass washer stamped PLS 1106 nailed to face of blaze. Attached signs 54-3 & 54-9 and painted face of blaze and a 6" band of red around each BT. Set steel fence post West of corner and attached sign 54-9.

Compass declination 19° East.

I hereby certify that the above corner monument was properly remonumented to U.S.F.S. standards under my supervision and witnessed by Scott Munro on May 28, 1987.

REGISTERED PROFESSIONAL LAND SURVEYOR

William R. Wells

OREGON JULY 22, 1977 WILLIAM R. WELLS 1106

Office of... County Surveyor..... County of... Baker.....

State of... Oregon....., I hereby certify that the within instrument was filed in this office for record on the..... day of....., 19.....

..... by
(COUNTY OFFICIAL) (DEPUTY)