


CERTIFIED RECORD OF LAND CORNER MONUMENTATION

H-25 1

History of original corner establishment:

None. Corner established with this survey.

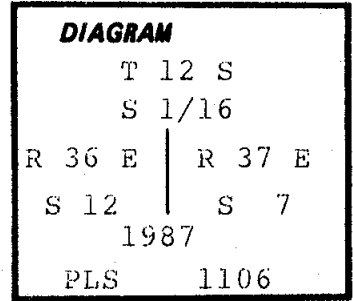

Description of corner evidence found:

None.

Description of monument and accessories established to perpetuate the original location of this corner:

At position established by survey...

Set 2½" aluminum pipe with 2½" aluminum cap 24" in the ground and surrounded with a mound of earth and stone. Cap marked as shown in corner diagram.

New bearing trees established:

A 8" juniper brs S42½° E, 90.0' dist mkd S1/16S7 BT.

A 10" ponderosa pine brs N09° W, 73.5' dist mkd S1/16S12 BT.

New bearing trees have a brass washer stamped PLS 1106 nailed to face of blaze. Attached signs 54-3 & 54-9, painted face of blaze and 6" band of red around each BT. Set steel fence post South of corner and attached sign 54-9 & 54-2.

Compass declination 19° East.

I hereby certify that the above corner monument was properly established to U.S.F.S. standards by me on November 16, 1987.

REGISTERED
PROFESSIONAL
LAND SURVEYOR

William R. Wells

OREGON
JULY 22, 1977
WILLIAM R. WELLS
1106

Office of... County Surveyor..... County of... Baker
State of... Oregon....., I hereby certify that the within instrument was filed in this office
for record on the..... day of....., 19.....

..... by
(COUNTY OFFICIAL) (DEPUTY)