

CERTIFIED RECORD OF LAND CORNER MONUMENTATION

A-5


History of original corner establishment:

Corner originally established by Eugene P. McCornack under Contract No. 398 and dated July 02, 1881.

Surveyor General records state:

Set post 4' long 4" square 24" in ground for corner to Secs 5, 6, 31 & 32 marked T11SS32 on NE, R37ES5 on SE, T12SS6 on SW and S31 on NW face with 5 notches on E and 1 notch on W edge from which:

- A pine 36" dia brs N40°E, 51 lks dist mkd T11SR37ES32 BT.
- A pine 36" dia brs S60°E, 75 lks dist mkd T12SR37ES5 BT.
- A pine 3" dia brs S75°W, 67 lks dist mkd T12SR37ES6 BT.
- A pine 24" dia brs N30°W, 132 lks dist mkd T11SR37ES31 BT.

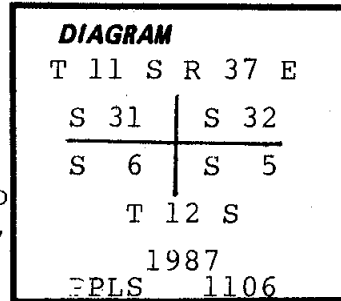

Description of corner evidence found:

None. Corner search of 6 hours on 3 different occasions with 2 man crew including 1 PLS. There is a location poster on tree 100' south indicating approx corner is 3 chains North. The area has been logged & burnt & is now a pasture.

Description of monument and accessories established to perpetuate the original location of this corner:

Re-established corner by single proportionate measure between found $\frac{1}{4} \frac{S\ 31}{S\ 6}$ and found $\frac{S\ 32}{S\ 5} | \frac{S\ 33}{S\ 4}$...

Set 2½" aluminum pipe with 2½" aluminum cap 22" in the ground and surrounded with a mound of earth and stone. Cap marked as shown in corner diagram.

New bearing trees established:

- A 21" ponderosa pine brs N06°E, 159.4' dist mkd T11SR37ES32 BT.
- A 11" ponderosa pine brs S03°E, 119.4' dist mkd T12SR37ES5 BT.
- A 13" ponderosa pine brs S20½°W, 99.7' dist mkd T12SR37ES6 BT.
- A 20" ponderosa pine brs N9½°W, 109.6' dist mkd T11SR37ES31 BT.

New bearing trees have a brass washer stamped PLS 1106 nailed to face of blaze. Attached signs 54-3 & 54-9, painted face of blaze and 6" band of red around each BT. Set steel fence post West of corner and attached sign 54-9 & 54-2.

Compass declination 19° East.

I hereby certify that the above corner monument was properly re-established to U.S.F.S. standards by me on November 02, 1987.

**REGISTERED
PROFESSIONAL
LAND SURVEYOR**

William R. Wells

**OREGON
JULY 22, 1977
WILLIAM R. WELLS
1106**

Office of.....County Surveyor..... County of.....Baker.....
 State of.....Oregon....., I hereby certify that the within instrument was filed in this office
 for record on the..... day of....., 19.....
 by
 (COUNTY OFFICIAL) (DEPUTY)

FILED 1-21-88
 BAKER COUNTY SURVEYOR
 SURVEY NO. 12-37-24