

CERTIFIED RECORD OF LAND CORNER MONUMENTATION


A-7

History of original corner establishment:

Corner originally established by Eugene P. McCornack under Contract No. 398 and dated July 02, 1881.

Surveyor General records state:

Set basalt stone 12 x 11 x 9", 8" in ground for 1/4 Sec Cor marked 1/4 on N face and raised a mound of stone alongside, pits impracticable.

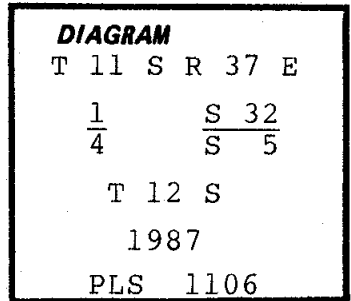

Description of corner evidence found:

None. Corner searched 4 separate times with 2 person crew including 1 PLS. Believe corner is destroyed by road. USFS search by J. Mitchell was for N1/4 Sec 32, not this corner. Total search time was 6 hours.

Description of monument and accessories established to perpetuate the original location of this corner:

Re-established corner by single proportionate measure between found N1/4S6 and found NE corner of sec 5...

NOTE: There is an old location poster saying "Approx 1/4" SE of corner point about 30' on a fence.

Set 2 1/2" aluminum pipe with 2 1/2" aluminum cap 22" in the ground and surrounded with a mound of earth and stone. Cap marked as shown in corner diagram.


New bearing tree established:

A 10" juniper brs N07 1/2° W, 75.7' dist mkd 1/4S32 BT on double blaze. No BT is available in Sec 5 so a reference monument was set. Reference monument is a 5/8" x 30" rebar with 1 1/2" aluminum cap mkd as shown. Set steel fence post next to reference monument and attached sign 54-3 & 54-9. The reference monument brs S64 1/2° E, 17.7' from corner.

New bearing tree ~~has~~ a brass washer stamped PLS 1106 nailed to face of ~~blaze~~ ^{lower} blaze. Attached signs 54-3 & 54-9, painted face of blaze and 6" band of red around each BT. Set steel fence post East of corner and attached sign 54-9.

Compass declination 19° East.

I hereby certify that the above corner monument was properly re-established to U.S.F.S. standards by me on November 03, 1987.

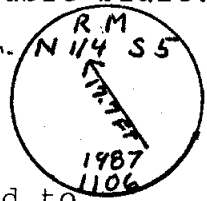

**REGISTERED
PROFESSIONAL
LAND SURVEYOR**

William R. Wells

OREGON
JULY 22, 1977
WILLIAM R. WELLS
1106

Office of.....County Surveyor.....County of.....Baker.....
State of.....Oregon....., I hereby certify that the within instrument was filed in this office
for record on the..... day of....., 19.....
..... by

(COUNTY OFFICIAL)

(DEPUTY)