


CERTIFIED RECORD OF LAND CORNER MONUMENTATION

C-2

History of original corner establishment:

None. Corner established with this survey.

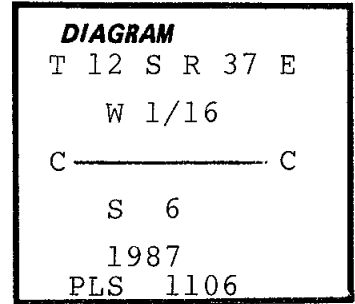

Description of corner evidence found:

None.

Description of monument and accessories I established to perpetuate the original location of this corner:

At position established by survey...

Set 2 1/2" aluminum pipe with 2 1/2" aluminum cap 20" in the ground and surrounded with a mound of earth and stone. Cap marked as shown in corner diagram.

New bearing trees established:

- A 11" ponderosa pine brs S07°W, 37.4' dist mkd C-W1/16S6 BT.
- A 8" ponderosa pine brs S40 1/2°E, 46.3' dist mkd C-W1/16S6 BT.

New bearing trees have a brass washer stamped PLS 1106 nailed to face of blaze. Attached signs 54-3 & 54-9, painted face of blaze and 6" band of red around each BT. Set steel fence post N & W of corner and attached sign 54-9 to one post & 54-2 to both posts.

Compass declination 19° East.

I hereby certify that the above corner monument was properly established to U.S.F.S. standards by me on November 17, 1987.

REGISTERED PROFESSIONAL LAND SURVEYOR

William R. Wells

OREGON JULY 22, 1977 WILLIAM R. WELLS 1106

Office of... County Surveyor County of... Baker

State of... Oregon I hereby certify that the within instrument was filed in this office
for record on the..... day of....., 19.....

..... by

(COUNTY OFFICIAL) (DEPUTY)

FILED 1-21-88

BAKER COUNTY SURVEYOR

SURVEY NO. 12-37-31