


CERTIFIED RECORD OF LAND CORNER MONUMENTATION

C-3

History of original corner establishment:

None. Corner established with this survey.

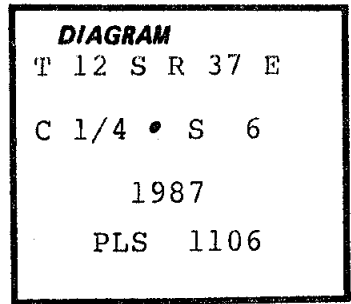

Description of corner evidence found:

None.

Description of monument and accessories established to perpetuate the original location of this corner:

At position established by survey...

Set 2½" x 30" aluminum pipe with 2½" aluminum cap 15" in ground to bedrock and surrounded with a mound of earth and stone. Cap marked as shown in corner diagram.

New bearing trees established:

A 21" ponderosa pine brs N69°W, 36.2' mkd C1/4S6 BT.

A 8" ponderosa pine brs N29½°E, 19.6' mkd C1/4S6 BT.

New bearing trees have a brass washer stamped PLS 1106 nailed to face of blaze. Attached signs 54-3 & 54-9, painted face of blaze and 6" band of red around each BT. Set steel fence post North of corner and attached sign 54-9.

Compass declination 19° East.

I hereby certify that the above corner monument was properly established to U.S.F.S. standards by me on November 19, 1987.

REGISTERED PROFESSIONAL LAND SURVEYOR

William R. Wells

OREGON JULY 22, 1977 WILLIAM R. WELLS 1106

Office of..... County Surveyor..... County of..... Baker.....
Oregon..... I hereby certify that the within instrument was filed in this office
for record on the..... day of....., 19.....

..... by
(COUNTY OFFICIAL) (DEPUTY)

FILED 1-21-88
BAKER COUNTY SURVEYOR
SURVEY NO. 12-37-32