

CERTIFIED RECORD OF LAND CORNER MONUMENTATION


C-5

History of original corner establishment:

Corner originally established by William R. Gradon under Contract No. 409 and dated March 28, 1882.

Surveyor General records state:

Set a basalt stone 16 x 16 x 12", 11" in ground for 1/4 Sec Cor marked 1/4 on W face and raised a mound of stone alongside.

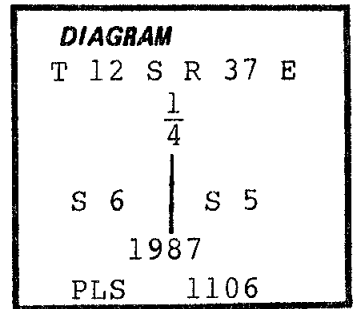

Description of corner evidence found:

Found a 13 x 13 x 9" (record, 16 x 16 x 12") basalt stone firmly set in stone mound, marked 1/4 on W face.

Description of monument and accessories I established to perpetuate the original location of this corner:

At position of found original basalt stone...

Set 2 1/2" aluminum pipe with 2 1/2" aluminum cap 22" in the ground and surrounded with a mound of earth and stone. Cap marked as shown in corner diagram. Buried corner stone in mound.

New bearing trees established:


A 14" ponderosa pine brs S89 1/2° E, 66.2' dist mkd 1/4S5 BT.

A 14" juniper brs S40° W, 1.6' dist mkd 1/4S6 BT.

New bearing trees have a brass washer stamped PLS 1106 nailed to face of blaze. Attached signs 54-3 & 54-9, painted face of blaze and 6" band of red around each BT. Set steel fence post North of corner and attached sign 54-9.

Compass declination 19° East.

I hereby certify that the above corner monument was properly remonumented to U.S.F.S. standards by me on November 17, 1987.

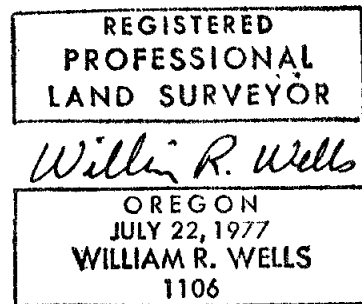

Office of.....County Surveyor.....County of.....Baker
State of.....Oregon.....I hereby certify that the within instrument was filed in this office
for record on the.....day of....., 19.....
.....by
(COUNTY OFFICIAL) (DEPUTY)