


CERTIFIED RECORD OF LAND CORNER MONUMENTATION

History of original corner establishment:

None. Corner established with this survey.

C-7

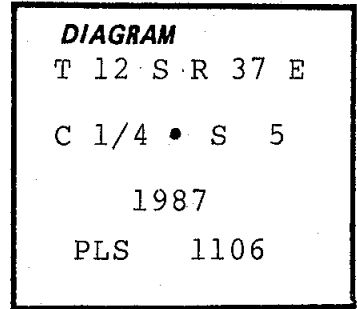

Description of corner evidence found:

None.

Description of monument and accessories established to perpetuate the original location of this corner:

At position established by survey...

Set 2 1/2" x 30" aluminum pipe with 2 1/2" aluminum cap 27" in the ground and surrounded with a mound of earth only. Cap marked as shown in corner diagram.

There are no bearing trees available (corner falls in meadow), so set 2 reference monuments.


Reference monuments are 5/8" pins with 1 1/2" aluminum caps marked as shown. A reference monument brs S73 1/2° W, 35.7' mkd: A reference monument brs N37° W, 40.1' mkd:

Set steel fence post near each R.M. & attached signs 54-3 & 54-9. Set steel fence post N & S of corner and attached sign 54-2 to both posts & 54-9 to one post.

Compass declination 19° East.

I hereby certify that the above corner monument was properly established to U.S.F.S. standards by me on November 18, 1987.

Note: 5/8" pins are 30" long. Reference monuments are set in fence line.

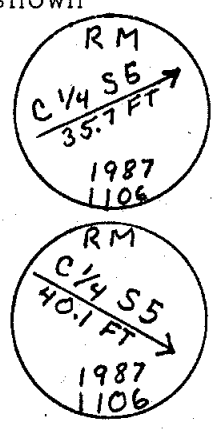

REGISTERED PROFESSIONAL LAND SURVEYOR

William R. Wells
OREGON
JULY 22, 1977
WILLIAM R. WELLS
1106

Office of.....County Surveyor..... County of.....Baker.....
State of.....Oregon....., I hereby certify that the within instrument was filed in this office
for record on the..... day of....., 19.....
..... by
(COUNTY OFFICIAL) (DEPUTY)