

CERTIFIED RECORD OF LAND CORNER MONUMENTATION


C-9

History of original corner establishment:

Corner originally established by William R. Gradon under Contract No. 409 and dated March 28, 1882.

Surveyor General records state:

Set a basalt stone 18 x 16 x 16", 12" in ground for 1/4 Sec Cor marked 1/4 on W face, dug pits 18 x 18 x 12" N & S of Cor 5 1/2' dist and raised a mound of earth 1 1/2' high 3 1/2' base alongside.

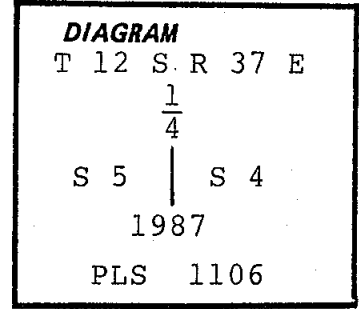

Description of corner evidence found:

Found a 20 x 15 x 10" (record, 18 x 16 x 16") basalt stone marked 1/4, loose in stone mound beside 2" galvanized iron pipe. The original stone  $\checkmark$  been moved & the pipe set in its place. appears to have

Description of monument and accessories established to perpetuate the original location of this corner:

At position of 2" galvanized iron pipe:

Set 2 1/2" x 30" aluminum pipe with 2 1/2" aluminum cap 24" in the ground and surrounded with a mound of earth and stone. Cap marked as shown in corner diagram. Buried original stone and iron pipe in new mound.

New bearing trees established:

A 10" SW stem of 2 stem juniper brs N74 1/2° E, 79.1' mkd 1/4S4 BT (measured to rootcrown of double tree)  
A 17" ponderosa pine brs N04° W, 251.8' dist mkd 1/4S5 BT.

New bearing trees have a brass washer stamped PLS 1106 nailed to face of blaze. Attached signs 54-3 & 54-9, painted face of blaze and 6" band of red around each BT. Set steel fence post South of corner and attached sign 54-9.

Compass declination 19° East.

I hereby certify that the above corner monument was properly remonumented to U.S.F.S. standards by me on November 19, 1987.

REGISTERED  
PROFESSIONAL  
LAND SURVEYOR

*William R. Wells*

OREGON  
JULY 22, 1977  
WILLIAM R. WELLS  
1106

Office of..... County Surveyor..... County of..... Baker  
State of..... Oregon....., I hereby certify that the within instrument was filed in this office  
for record on the..... day of....., 19.....

..... by .....  
(COUNTY OFFICIAL) (DEPUTY)