


CERTIFIED RECORD OF LAND CORNER MONUMENTATION

D-6

History of original corner establishment:

None. Corner established with this survey.

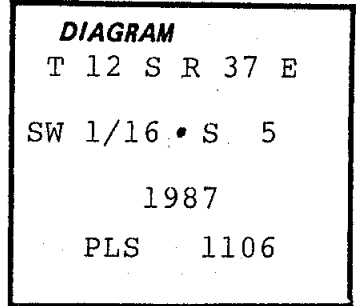

Description of corner evidence found:

None.

There is a 1957 location poster on a dead mahogany 12' northeast of corner point and a BLM steel fence post with tag S38°E-49.5' from corner point.

Description of monument and accessories I established to perpetuate the original location of this corner:

At position established by survey...

Set 2½" aluminum pipe with 2½" aluminum cap 24" in the ground and surrounded with a mound of earth and stone. Cap marked as shown in corner diagram.

New bearing trees established:

A 12" ponderosa pine brs S83½°E, 19.7' dist mkd SW1/16S5 BT.

A 6" ponderosa pine brs N15½°W, 11.0' dist mkd SW1/16S5 BT.

New bearing trees have a brass washer stamped PLS 1106 nailed to face of blaze. Attached signs 54-3 & 54-9, painted face of blaze and 6" band of red around each BT. Set steel fence post East. of corner and attached sign 54-9.

Compass declination 19° East.

I hereby certify that the above corner monument was properly established to U.S.F.S. standards by me on November 17, 1987.

REGISTERED PROFESSIONAL LAND SURVEYOR
---

*William R. Wells*

OREGON JULY 22, 1977 WILLIAM R. WELLS 1106
---

Office of.....County Surveyor..... County of.....Baker.....  
 State of.....Oregon....., I hereby certify that the within instrument was filed in this office  
 for record on the..... day of....., 19.....  
 ..... by .....  
 (COUNTY OFFICIAL) (DEPUTY)