


CERTIFIED RECORD OF LAND CORNER MONUMENTATION

D-7

History of original corner establishment:

None. Corner established with this survey.

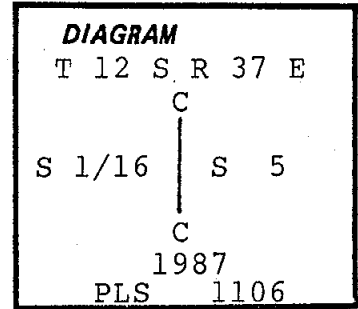

Description of corner evidence found:

NOTE: BLM Administrative Corner (steel fence post) brs S18°W, 48' dist. - this post has a BLM tag.

A 1½" pipe (origin unknown) & old USFS location poster brs S85°W, 34.1' from corner.

Description of monument and accessories established to perpetuate the original location of this corner:

At position established by survey...

Set 2½" x 30" aluminum pipe with 2½" aluminum cap 10" in ground to bedrock and surrounded with a mound of earth and stone. Cap marked as shown in corner diagram.

New bearing trees established:

A 9" ponderosa pine brs S62½°W, 22.0' dist mkd C-S1/16S5 BT.

A 10" ponderosa pine brs S01°W, 22.3' dist mkd C-S1/16S5 BT.

New bearing trees have a brass washer stamped PLS 1106 nailed to face of blaze. Attached signs 54-3 & 54-9, painted face of blaze and 6" band of red around each BT. Set steel fence post North of corner and attached sign 54-9 & 54-2.

Compass declination 19° East.

I hereby certify that the above corner monument was properly established to U.S.F.S. standards by me on November 18, 1987.

REGISTERED PROFESSIONAL LAND SURVEYOR.
--

William R. Wells

OREGON JULY 22, 1977 WILLIAM R. WELLS 1106

Office of.....County Surveyor..... County of.....Baker.....

State of.....Oregon....., I hereby certify that the within instrument was filed in this office for record on the..... day of....., 19.....

..... by
(COUNTY OFFICIAL) (DEPUTY)