


CERTIFIED RECORD OF LAND CORNER MONUMENTATION

E-2

**History of original corner establishment:**

None. Corner established with this survey.

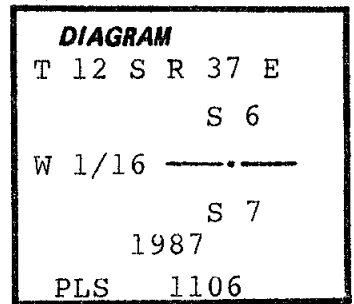

**Description of corner evidence found:**

None.

**Description of monument and accessories I established to perpetuate the original location of this corner:**

At position established by survey...

Set 2½" x 30" aluminum pipe with 2½" aluminum cap 24" in the ground and surrounded with a mound of earth and stone. Cap marked as shown in corner diagram.

**New bearing trees established:**

- A 6" ponderosa pine brs N83°W, 43.7' mkd W1/16S6 BT.
- A 9" ponderosa pine brs S28½°E, 31.5' mkd W1/16S7 BT.

New bearing trees have a brass washer stamped PLS 1106 nailed to face of blaze. Attached signs 54-3 & 54-9, painted face of blaze and 6" band of red around each BT. Set steel fence post West of corner and attached sign 54-9.

Compass declination 19° East.

I hereby certify that the above corner monument was properly established to U.S.F.S. standards by me on November 19, 1987.

REGISTERED PROFESSIONAL LAND SURVEYOR
---

*William R. Wells*

OREGON JULY 22, 1977 WILLIAM R. WELLS 1106
---

Office of.....County Surveyor..... County of.....Baker.....  
State of.....Oregon....., I hereby certify that the within instrument was filed in this office  
for record on the..... day of....., 19.....

..... by .....  
(COUNTY OFFICIAL) (DEPUTY)

FILED 1-21-88  
BAKER COUNTY SURVEYOR  
SURVEY NO. 12-37-39