

CERTIFIED RECORD OF LAND CORNER MONUMENTATION


E-9

**History of original corner establishment:**

Corner originally established by William R. Gradon under Contract No. 409 and dated March 28, 1882.

**Surveyor General records state:**

Set a post 4' long 4" square with marked stone 12" in ground for cor to secs 4,5,8 & 9 marked T12SS4 on NE, R37ES9 on SE, S8 on SW and S5 on NW faces with 4 notches on E edges, dug pits 18x18x12" in each sec 5½' dist and raised a mound of earth 2' high 4½' base around post.

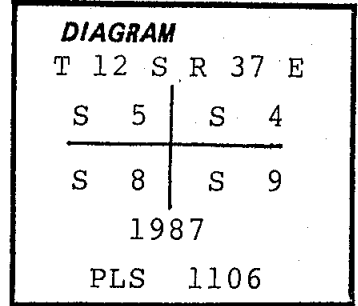

**Description of corner evidence found:**

Found no trace of original post, marked stone or earth mound after 2 hrs search with 2 person crew with 1 PLS. There are fences running E, W & S from corner area. After surveying to adjacent found corners, and finding the observed bearings and distance are close to record, I accept the fence corner as the best available evidence of the original corner location.

**Description of monument and accessories I established to perpetuate the original location of this corner:**

At position of fence intersection, accepted as best available evidence...

Set 2½" x 30" aluminum pipe with 2½" aluminum cap 24" in the ground and surrounded with a mound of earth and stone. Cap marked as shown in corner diagram.

**New bearing trees established:**

- A 9" ponderosa pine brs N15½° E, 53.2' mkd T12SR37ES4 BT.
- A 24" ponderosa pine brs S16½° E, 88.4' mkd T12SR37ES9 BT.
- A 6" juniper brs S27½° W, 58.4' mkd T12SR37ES8 BT.
- A 19" ponderosa pine brs N46° W, 29.9' mkd T12SR37ES5 BT.

New bearing trees have a brass washer stamped PLS 1106 nailed to face of blaze. Attached signs 54-3 & 54-9, painted face of blaze and 6" band of red around each BT. Set steel fence post North of corner and attached sign 54-9.

Compass declination 19° East.

I hereby certify that the above corner monument was properly remonumented to U.S.F.S. standards by me on November 19, 1987.

REGISTERED PROFESSIONAL LAND SURVEYOR
---

*William R. Wells*

OREGON JULY 22, 1977 WILLIAM R. WELLS 1106
---

Office of.....County Surveyor..... County of... Baker.....  
State of..... Oregon....., I hereby certify that the within instrument was filed in this office  
for record on the..... day of....., 19.....

..... by .....  
(COUNTY OFFICIAL) (DEPUTY)