

CERTIFIED RECORD OF LAND CORNER MONUMENTATION


E-11

History of original corner establishment:

Corner originally established by William R. Gradon under Contract No. 409 and dated March 28, 1882.

Surveyor General records state:

Set a basalt stone 16 x 12 x 12" 11 ins in ground for 1/4 sec cor marked 1/4 on N face and raised a mound of stone alongside.

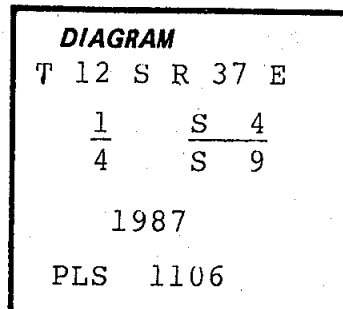

Description of corner evidence found:

Found a nice mound of stone 3 1/2' in diam and 1 1/2' high, several stones in mound are near record size, but could find no definite marks. This stone mound is ancient and is similar in all respects to other found original corner mounds built by Surveyor Gradon.

Description of monument and accessories established to perpetuate the original location of this corner:

At center of stone mound...

Set 2 1/2" x 30" aluminum pipe with 2 1/2" aluminum cap 22" in the ground and surrounded with a mound of earth and stone. Cap marked as shown in corner diagram.

New bearing trees established:

- A 17" juniper brs N76°E, 37.9' mkd 1/4S4 BT.
- A 11" juniper brs S70°E, 106.3' mkd 1/4S9 BT.

New bearing trees have a brass washer stamped PLS 1106 nailed to face of blaze. Attached signs 54-3 & 54-9, painted face of blaze and 6" band of red around each BT. Set steel fence post East. of corner and attached sign 54-9.

Compass declination 19° East.

I hereby certify that the above corner monument was properly re-monumented to U.S.F.S. standards by me on November 19, 1987.

REGISTERED  
PROFESSIONAL  
LAND SURVEYOR

*William R. Wells*

OREGON  
JULY 22, 1977  
WILLIAM R. WELLS  
1106

Office of.....County Surveyor..... County of.....Baker.....  
 State of.....Oregon....., I hereby certify that the within instrument was filed in this office  
 for record on the..... day of....., 19.....  
 ..... by .....  
 (COUNTY OFFICIAL) (DEPUTY)

FILED 1-21-88  
 BAKER COUNTY SURVEYOR  
 SURVEY NO. 12-37-43