


CERTIFIED RECORD OF LAND CORNER MONUMENTATION

F-9

**History of original corner establishment:**

None. Corner established with this survey.

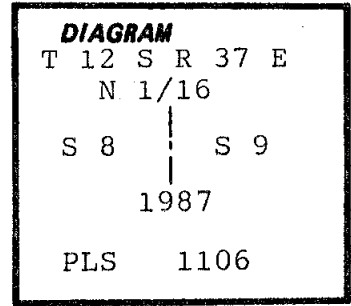

**Description of corner evidence found:**

None.

**Description of monument and accessories I established to perpetuate the original location of this corner:**

At position established by survey...

Set a 2½" x 30" aluminum pipe with 2½" aluminum cap 7" in ground to bedrock and surrounded with mound of earth and stone. Cap marked as shown in corner diagram.

**New bearing trees established:**

- A 7" juniper brs S59°E, 59.7' scribed N1/16S9 BT.
- A 9" ponderosa pine brs S74½°W, 26.1' scribed N1/16S8 BT

New bearing trees have a brass washer stamped PLS 1106 nailed to face of blaze. Attached signs 54-3 & 54-9 and painted face of blaze and a 6" band of red around each BT. Set steel fence post North of corner and attached sign 54-9.

Compass declination 19° East.

I hereby certify that the above corner monument was properly established to U.S.F.S. standards by me on November 3, 1987.

REGISTERED PROFESSIONAL LAND SURVEYOR
---

*William R. Wells*

OREGON JULY 22, 1977 WILLIAM R. WELLS 1106
---

Office of..... County Surveyor Baker  
 State of..... Oregon , I hereby certify that the within instrument was filed in this office  
 for record on the..... day of..... , 19.....  
 ..... by .....  
 (COUNTY OFFICIAL) (DEPUTY)

FILED 1-21-88  
 BAKER COUNTY SURVEYOR  
 SURVEY NO. 12-37-45