


CERTIFIED RECORD OF LAND CORNER MONUMENTATION

G-2

**History of original corner establishment:**

None. Corner established with this survey.

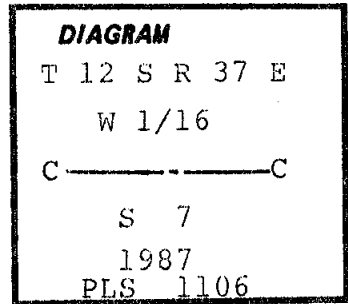

**Description of corner evidence found:**

None.

**Description of monument and accessories established to perpetuate the original location of this corner:**

At position established by survey...

Set 2½" aluminum pipe with 2½" aluminum cap 20" in the ground and surrounded with a mound of earth and stone. Cap marked as shown in corner diagram.

**New bearing trees established:**

A 8" douglas fir brs N74°W, 7.5' dist mkd C-W1/16S7 BT.

A 11" ponderosa pine brs N22½°W, 57.4' dist mkd C-W1/16S7 BT.

New bearing trees have a brass washer stamped PLS 1106 nailed to face of blaze. Attached signs 54-3 & 54-9, painted face of blaze and 6" band of red around each BT. Set steel fence post North of corner and attached sign 54-9.

Compass declination 19° East.

I hereby certify that the above corner monument was properly established to U.S.F.S. standards by me on November 16, 1987.

REGISTERED PROFESSIONAL LAND SURVEYOR
---

*William R. Wells*

OREGON JULY 22, 1977 WILLIAM R. WELLS 1106
---

Office of...County Surveyor..... County of...Baker.....  
State of...Oregon....., I hereby certify that the within instrument was filed in this office  
for record on the..... day of....., 19.....

..... by .....  
(COUNTY OFFICIAL) (DEPUTY)