


CERTIFIED RECORD OF LAND CORNER MONUMENTATION

G-7

History of original corner establishment:

None. Corner established with this survey.

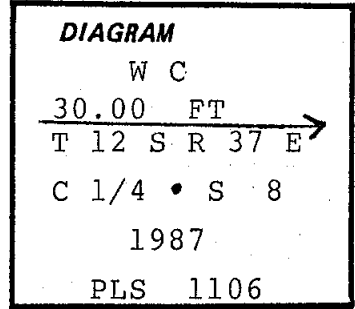

Description of corner evidence found:

None.

Description of monument and accessories established to perpetuate the original location of this corner:

Corner point falls on the face of a cliff 200' high so at a point S89°53'36"W-30.00 feet from corner point:

Set a witness corner which is a 2½" x 30" aluminum pipe with 2½" aluminum cap set 22" in ground & surrounded with a mound of earth and stone.

New bearing trees established:

A 17" ponderosa pine brs N83°W, 42.5' dist FROM true corner point & N67°W, 13.2' FROM W.C. monument mkd "X" at breast height & BT at base.

A 21" ponderosa pine brs S63½°W, 46.7' FROM true corner point & S29½°W, 23.9' FROM W.C. monument mkd "X" at breast height & BT at base.

New BTs have a brass washer stamped PLS 1106 nailed to face of blaze, attached sign 54-3 & 54-9 & painted face of blaze & 6" red band around each BT. The BTs have 54-3 signs for both the true corner point & the W.C. monument. Set steel fence post South of corner & attached sign 54-9.

Compass declination 19° East.

I hereby certify that the above corner monument was properly established to U.S.F.S. standards by me on November 18, 1987.

REGISTERED
PROFESSIONAL
LAND SURVEYOR

William R. Wells

OREGON
JULY 22, 1977
WILLIAM R. WELLS
1106

Office of.....County Surveyor..... County of.....Baker.....

State of.....Oregon....., I hereby certify that the within instrument was filed in this office

for record on the..... day of....., 19.....

..... by

(COUNTY OFFICIAL)

(DEPUTY)