

CERTIFIED RECORD OF LAND CORNER MONUMENTATION

G-9


History of original corner establishment:

Corner originally established by William R. Gradon under Contract No. 409 and dated March 28, 1882.

Surveyor General records state:

Set a basalt stone 16 x 14 x 8", 11" in ground for 1/4 sec Cor marked 1/4 on W face from which:

A mahogany 6" dia brs N20^oE, 5 lks dist marked 1/4S BT.
A mahogany 4" dia brs N88^oW, 4 lks dist marked 1/4S BT.

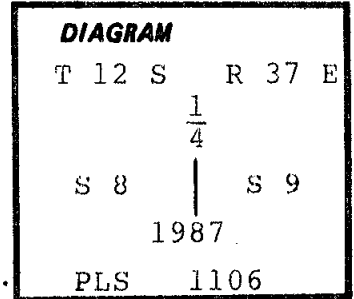

Description of corner evidence found:

Found a 16 x 14 x 6" (record, 16 x 14 x 8") basalt stone with faint marks and tipped over from which:

A dead down 5" mahogany brs N88^oW, 2.6' dist with axe marks and faint scribes on open blaze.

Description of monument and accessories I established to perpetuate the original location of this corner:

At postition of found original stone...

Set 2 1/2" aluminum pipe with 2 1/2" aluminum cap 8" in the ground to bedrock and surrounded with a mound of earth and stone. Cap marked as shown in corner diagram. Buried original stone alongside.

New bearing trees established:

A 10" juniper brs N88^oE, 15.3' mkd 1/4S9 BT.
A 12" ponderosa pine brs N75 1/2^oW, 47.9' mkd 1/4S8 BT.

New bearing trees have a brass washer stamped PLS 1106 nailed to face of blaze. Attached signs 54-3 & 54-9, painted face of blaze and 6" band of red around each BT. Set steel fence post North of corner and attached sign 54-9.

Compass declination 19^o East.

I hereby certify that the above corner monument was properly remonumented to U.S.F.S. standards by me on November 03, 1987.

REGISTERED
PROFESSIONAL
LAND SURVEYOR

William R. Wells

OREGON
JULY 22, 1977
WILLIAM R. WELLS
1106

Office of..... County Surveyor..... County of..... Baker.....
State of..... Oregon....., I hereby certify that the within instrument was filed in this office
for record on the..... day of....., 19.....
..... by
(COUNTY OFFICIAL) (DEPUTY)