

CERTIFIED RECORD OF LAND CORNER MONUMENTATION


J-3

History of original corner establishment:

Corner originally established by William R. Gradon under Contract No. 409 and dated March 28, 1882.

Surveyor General records state:

Set a basalt stone 14 x 10 x 10", 10" in ground for 1/4 sec Cor marked 1/4 on N face and raised a mound of stone alongside.

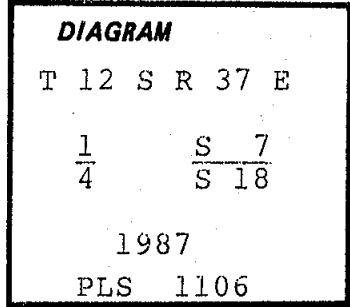

Description of corner evidence found:

Found a basalt stone 18 x 14 x 3" (record, 14 x 10 x 10") in scattered stone mound marked 1/4 on down side (stone had tipped North).

Description of monument and accessories established to perpetuate the original location of this corner:

At position of found original basalt stone...

Set 2 1/2" aluminum pipe with 2 1/2" aluminum cap 24" in the ground and surrounded with a mound of earth and stone. Cap marked as shown in corner diagram. Buried corner stone in new mound.

New bearing trees established:

A 10" juniper brs N53°W, 5.0' dist mkd 1/4S7 BT.
The 12" East stem of a forked juniper brs S52°W, 73.9' dist mkd 1/4S18 BT. (measured to center of root crown)

New bearing trees have a brass washer stamped PLS 1106 nailed to face of blaze. Attached signs 54-3 & 54-9. Omitted painting bearing trees because of nearby house. Set steel fence post East of corner and attached sign 54-9.

Compass declination 19° East.

I hereby certify that the above corner monument was properly remonumented to U.S.F.S. standards by me on November 16, 1987.

REGISTERED
PROFESSIONAL
LAND SURVEYOR

William R. Wells

OREGON
JULY 22, 1977
WILLIAM R. WELLS
1106

Office of.....County Surveyor..... County of..... Baker.....
State of..... Oregon....., I hereby certify that the within instrument was filed in this office
for record on the..... day of....., 19.....

..... by
(COUNTY OFFICIAL) (DEPUTY)