


CERTIFIED RECORD OF LAND CORNER MONUMENTATION

J-4

History of original corner establishment:

None. Corner established with this survey.

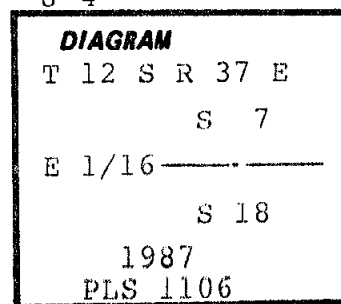

Description of corner evidence found:

None.

Description of monument and accessories I established to perpetuate the original location of this corner:

At position established by survey...

Set 2½" aluminum pipe with 2½" aluminum cap 22" in the ground and surrounded with a mound of earth and stone. Cap marked as shown in corner diagram.

New bearing trees established:

A 9" ponderosa pine brs N41½° E, 96.2' mkd E1/16S7 BT.

A 8" juniper brs S05½° W, 37.6' mkd E1/16S18 BT.

New bearing trees have a brass washer stamped PLS 1106 nailed to face of blaze. Attached signs 54-3 & 54-9, painted face of blaze and 6" band of red around each BT. Set steel fence post West of corner and attached sign 54-9.

Compass declination 19° East.

I hereby certify that the above corner monument was properly established to U.S.F.S. standards by me on November 16, 1987.

REGISTERED
PROFESSIONAL
LAND SURVEYOR

William R. Wells

OREGON
JULY 22, 1977
WILLIAM R. WELLS
1106

Office of...County Surveyor..... County of...Baker.....

State of...Oregon..... I hereby certify that the within instrument was filed in this office
for record on the..... day of....., 19.....

..... by
(COUNTY OFFICIAL) (DEPUTY)

Form R6-7100-57 (9/71)

GPO-791-311

FILED 1-21-88

BAKER COUNTY SURVEYOR

SURVEY NO. 12-37-59