

CERTIFIED RECORD OF LAND CORNER MONUMENTATION

J-7


History of original corner establishment:

Corner originally established by William R. Gradon under Contract No. 409 and dated March 28, 1882.

Surveyor General records state:

Set a basalt stone 16 x 10 x 10", 11" in ground for 1/4 sec cor marked 1/4 on N face from which:

- A pine 36" dia brs S50°W, 7 lks dist mkd 1/4S BT.
- A pine 28" dia brs N15°W, 20 lks dist mkd 1/4S BT.

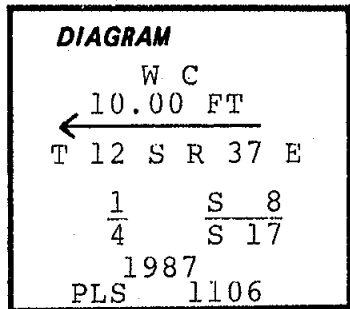

Description of corner evidence found:

Found a 13 x 11 x 8" (record, 16 x 10 x 11") basalt stone marked 1/4 on down side from which:

- A uprooted & washed out 12" douglas fir brs N15°W, 13.2' ± dist with scribes BT visible after opening blaze.
- A 24" down ponderosa pine with bottom 10' buried in silt brs S50°W, 4.6', believed to be the other BT.

Note: I believe the corner stone is in its original horizontal position even though it is below the high water line of the reservoir pool and the ground has eroded in the corner area.

Description of monument and accessories I established to perpetuate the

original location of this corner:

The corner point was reestablished at the position of the found corner stone and a witness corner monument was set N89°34'00"E-10.00' from corner position and above the reservoir high water line. Attached sign 54-3 to the 12" douglas fir bearing tree with bearing and distance to original corner point.

New BTs established for witness corner:

- A 27" ponderosa pine brs N11½°E, 56.0' FROM W.C. and N21°E, 58.9' FROM original corner position, mkd X at breast height & BT at base.
- A 8" juniper brs S39°E, 20.2' FROM W.C. and S55½°E, 27.6' FROM original corner position, mkd X at breast height & BT at base.

New bearing trees have a brass washer stamped PLS 1106 nailed to face of blaze. Attached signs 54-3 & 54-9, painted face of blaze and 6" band of red around each BT. Set steel fence post East of corner and attached sign 54-9. New BTs have 54-3 tags for both witness corner position and original corner position. Witness corner is a 2½" x 30" aluminum pipe with 2½" aluminum cap set 22" in ground and surrounded with mound of earth & stone. Buried original stone alongside the W.C. monument.

NOTE: Position of corner by J. Hanley per map 12-37-3 brs N13°E-186' from original corner position. See narrative on plat.

Compass declination 19° East.

I hereby certify that the above corner monument was properly remonumented to U.S.F.S. standards by me on November 17, 1987.

Note: Cap is marked as shown on corner diagram.

Office of..... County Surveyor..... County of..... Baker.....
 State of..... Oregon....., I hereby certify that the within instrument was filed in this office
 for record on the..... day of....., 19.....

..... by
 (COUNTY OFFICIAL) (DEPUTY)

REGISTERED
 PROFESSIONAL
 LAND SURVEYOR

William R. Wells

OREGON
 JULY 22, 1977
 WILLIAM R. WELLS
 1106