

**CERTIFIED RECORD OF LAND CORNER MONUMENTATION**


N-5

**History of original corner establishment:**

Corner originally established by William R. Gradon under Contract No. 409 and dated March 28, 1882.

**Surveyor General records state:**

Set a post 4' long 4" square with marked stone 12" in ground for cor to secs 17, 18, 19 & 20 marked T12SS17 on NE, R37ES20 on SE, S19 on SW and S18 on NW faces with 3 notches on S and 5 notches on E edges, dug pits 18 x 18 x 12" in each sec 5 1/2' dist and raised a mound of earth around post.

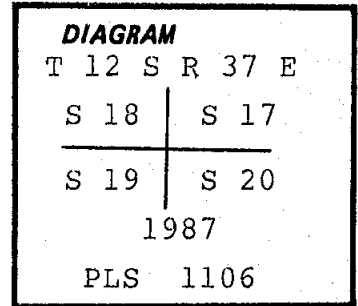

Map 12-37-3, filed Oct. 10, 1973, stamped by RPE 2808, states:

"Found 1" iron bar for Sec. Cor."

No other record of corner remonumentation was found in County Records.

**Description of corner evidence found:**

Found a 1" square by 24" long shaft protruding 6" out of ground, see map No. 12-37-3.

I accepted the 1" square shaft as the best remaining evidence of the location of the original corner after comparing record verses measured bearings and distances to the found or reestablished section corners one mile north and one mile west.

**Description of monument and accessories I established to perpetuate the original location of this corner:**

At position of 1" square shaft.....

Set 2 1/2" aluminum pipe with 2 1/2" aluminum cap 18" in the ground to bedrock and surrounded with a mound of earth and stone. Cap marked as shown in corner diagram. Buried shaft in new mound.

**New BTs established:**

A 12" juniper brs S77°E, 98.2' dist mkd T12SR37ES20 BT.  
A 12" juniper brs S44°W, 27.6' dist mkd T12SR37ES19 BT.  
A 11" juniper brs N06°W, 228.9' dist mkd T12SR37ES18 BT.  
No BT is available in NE quadrant so set reference monument, 5/8" x 30" rebar with 1 1/2" aluminum cap marked as shown here:  
Reference monument brs N31 1/2°E, 11.8' dist.



New bearing trees have a brass washer stamped PLS 1106 nailed to face of blaze. Attached signs 54-3 & 54-9, painted face of blaze and 6" band of red around each BT. Set steel fence post South of corner and attached sign 54-9. Set steel fence post near reference monument and attached sign 54-9 and 54-3.

Compass declination 19° East.

I hereby certify that the above corner monument was properly remonumented to U.S.F.S. standards by me on November 17, 1987.

REGISTERED  
PROFESSIONAL  
LAND SURVEYOR

*William R. Wells*

OREGON  
JULY 22, 1977  
WILLIAM R. WELLS  
1106

Office of...County...Surveyor..... County of...Baker.....  
State of..... Oregon....., I hereby certify that the within instrument was filed in this office  
for record on the..... day of....., 19.....

..... by .....  
(COUNTY OFFICIAL) (DEPUTY)