

NE 1/4 SECTION 31 T12S R37E WM  
 NW 1/4 SECTION 31 T12S R37E WM  
 SE 1/4 SECTION 31 T12S R37E WM  
 SW 1/4 SECTION 31 T12S R37E WM

T12S R36E R37E  
 S 25 | S 30  
 S 36 | S 31  
 PLS 1106 1987

OREGON STATE HIGHWAY DIVISION  
 T12S R37E  
 S 19 | S 20  
 S 30 | S 29  
 PLS 63148 2014

OREGON STATE HIGHWAY DIVISION  
 T12S R37E  
 1/4 S 30 | S 31  
 PLS 63148 2014

OREGON STATE HIGHWAY DIVISION  
 T12S R36E R37E  
 1/4 S 36 | S 31  
 PLS 63148 2014

1001 FOUND 14"x10"x11" STONE WITH NOTCHES ON 4 SIDES SW CORNER SECTION 31 3/25/14  
 REPLACED WITH 3/4" INSIDE DIAMETER X 30" LONG IRON PIPE WITH 2-1/2" BRASS CAP MARKED AS SHOWN SET ON 10/1/2014

T12S R36E R37E  
 S 1 | S 6  
 S 36 | S 31  
 PLS 63148 2014

1003 FOUND 14"x12"x6" STONE, FLUSH, WITH 5 NOTCHES ON EAST FACE AND 2 NOTCHES ON SOUTH FACE NE CORNER SEC. 30 8/23/14  
 REPLACED WITH 5/8"x30" IRON ROD WITH 3-1/4" ALUMINUM CAP MARKED AS SHOWN SET ON 10/1/2014

1002 FOUND 14"x11"x6" STONE MARKED "1/4" 3/25/14  
 REPLACED WITH 5/8" IRON ROD WITH 3-1/4" ALUMINUM CAP MARKED AS SHOWN SET ON 10/1/2014


1004 F.D. FENCE CORNER NE CORNER SECTION 34 4/23/13

LEGEND

- SET 5/8" X 30" IRON REBAR WITH ALUMINUM CAP MARKED "ODOT" UNLESS OTHERWISE NOTED
- FOUND MONUMENT
- ⊙ FOUND STONE REPLACED WITH MONUMENT AS NOTED
- ⊠ CALCULATED POSITION-NOTHING FOUND NOTHING SET
- ( ) RECORD DATA PER GLO FIELDNOTES
- [ ] RECORD DATA PER COUNTY SURVEY 1R-2-1439
- (( )) RECORD DATA PER ODOT DRG. NO. 2B-23-19
- [ [ ] RECORD DATA PER ODOT DRG. NO. 6B-34-4
- EXISTING RIGHT-OF-WAY
- ODOT PROPERTY BOUNDARY
- - - - ODOT LEASE BOUNDARY
- - - - EDGE OF PAVEMENT
- - - - EDGE OF GRAVEL
- X - FENCE

CONTROL NARRATIVE

PRIMARY CONTROL WAS ESTABLISHED ON THIS PROJECT BY USING GPS AND THE ONLINE POSITIONING USER SERVICE (OPUS) TO ESTABLISH A POSITION ON POINT L385. A SUBSEQUENT RTK GPS SURVEY WAS PERFORMED USING L385 AS A BASE POINT TO ESTABLISH POSITIONS ON ALL OF THE FOUND MONUMENTS SHOWN ON THIS SURVEY. THE BEARINGS SHOWN ON THIS SURVEY ARE GRID BEARINGS BASED ON THE OREGON STATE PLANE COORDINATE SYSTEM, NAD83 (2011) EPOCH 2010. COORDINATES WERE MOVED TO GROUND BY UTILIZING A LOCAL DATUM PLANE (LDP) COORDINATE SYSTEM. TO CONVERT THE PROJECT LDP COORDINATES TO THE OREGON COORDINATE SYSTEM, NORTH ZONE, NAD83 (2011) EPOCH 2010, MULTIPLY THE VALUES BY A COMBINED FACTOR OF 0.99977943.

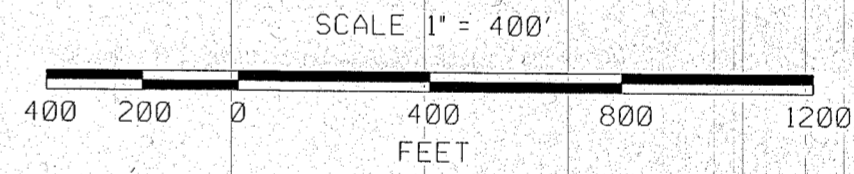

REGISTERED PROFESSIONAL LAND SURVEYOR

**BREL**  
 OREGON  
 JAN. 14, 2003  
 BRET N. ELITHORP  
 \*63148

RENEWS: DEC. 31, 2015  
 SIGNED: 12/18/14

FILED Dec. 19, 2014  
 BAKER COUNTY SURVEYOR  
 SURVEY NO. 12-37-86

OREGON DEPARTMENT OF TRANSPORTATION  
 MAP OF SURVEY  
 SECTION 31, T12S, R37E, W.M.  
 BAKER COUNTY  
 MATERIAL SOURCE AND STOCKPILE

ODOT REGION 5  
 3012 ISLAND AVENUE  
 LA GRANDE, OR 97850

OCTOBER, 2014  
 SCALE: 1"=400'  
 BEARINGS: GRID  
 SHEET 2 OF 3

