


CERTIFIED RECORD OF LAND CORNER MONUMENTATION

HISTORY OF ORIGINAL CORNER ESTABLISHMENT:

THIS CORNER WAS ORIGINALLY ESTABLISHED BY EUGENE P. McCORNACK UNDER CONTRACT NO. 398 DATED JULY 2, 1881.

SURVEYOR GENERAL LAND OFFICE RECORDS STATE:
 "SET BASALT STONE 18"X12"X6", 12" IN GROUND FOR THE 1/4 SECTION CORNER MARKED 1/4 ON THE WEST FACE AND RAISED A STONE MOUND ALONGSIDE. PITS IMPRACTICABLE"

DIAGRAM

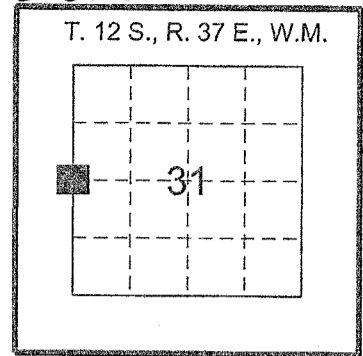

X-1

DESCRIPTION OF CORNER EVIDENCE FOUND:

CORNER NOT FOUND.


DESCRIPTION OF MONUMENT AND ACCESSORIES I ESTABLISHED TO PERPETUATE THE ORIGINAL LOCATION OF THIS CORNER:

RE-ESTABLISHED THE CORNER BY SINGLE PROPORTION BETWEEN THE FOUND NORTHWEST AND SOUTHWEST CORNERS OF SECTION 31, T12S, R37E, WM.

SET 3-1/4" ALUMINUM CAP ON A 5/8" X 30" IRON ROD, UP 4" ABOVE GROUND, SURROUNDED BY MOUND OF STONES, AND A POST WITH PADDLE PLACED ALONGSIDE. THE CAP IS MARKED AS SHOWN BELOW.

THE REFERENCES SET FOR SAID CORNER ARE AS FOLLOWS:

- 1) AN ORANGE DEEPI MAGNET BURIED 6" BELOW THE GROUND BEARS S54°36'04"E, 8.73 FEET.
- 2) A BLUE DEEPI MAGNET BURIED 7" BELOW THE GROUND BEARS N46°10'52"E, 9.63 FEET.
- 3) A 5/8" X 30" IRON ROD WITH A 1-1/2" ALUMINUM CAP, UP 8", STAMPED "ODOT" BEARS N45°15'13"W, 9.42 FEET.
- 4) A 5/8" X 30" IRON ROD WITH A 1-1/2" ALUMINUM CAP, UP 4", STAMPED "ODOT" BEARS S51°16'01"W, 12.05 FEET.

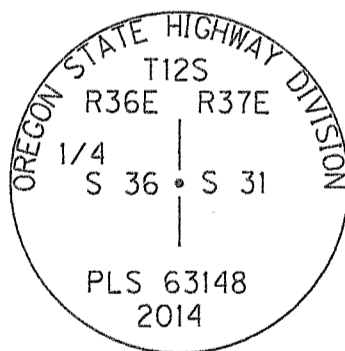

REGISTERED
PROFESSIONAL
LAND SURVEYOR

Bret Elithorp

OREGON
JAN 14, 2003
BRET N. ELITHORP
61348

RENEWS: 12/31/2015

WITNESSES:
 BRET ELITHORP, PLS
 MARK STEWART, CODY WHEELER

I HEREBY CERTIFY THAT THE ABOVE CORNER POSITION WAS RE-ESTABLISHED AS HEREON DESCRIBED ON SEPTEMBER 30, 2014.

FILED Dec. 19, 2014

BAKER COUNTY SURVEYOR

SURVEY NO 12-36-67 / 12-37-88

OREGON DEPARTMENT OF TRANSPORTATION



Section	CEMETERY QUARRY		
Highway	JOHN DAY HIGHWAY		
County	BAKER	Scale	NTS
Purpose	QUARRY BOUNDARY	Date	OCT. 20, 2014