


**CERTIFIED RECORD OF LAND CORNER MONUMENTATION**

**HISTORY OF ORIGINAL CORNER ESTABLISHMENT:**

NONE

**DIAGRAM**

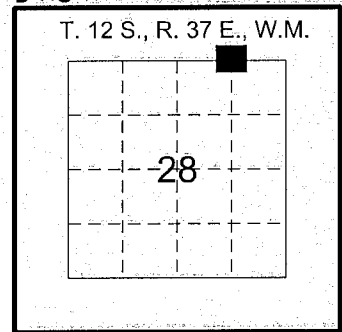

R-12

**DESCRIPTION OF CORNER EVIDENCE FOUND:**

NONE


**DESCRIPTION OF MONUMENT AND ACCESSORIES I ESTABLISHED TO PERPETUATE THE ORIGINAL LOCATION OF THIS CORNER:**

ESTABLISHED THE CORNER AS SHOWN ON THE RECORD OF SURVEY FOR THE UNITY RESERVOIR QUARRY BOUNDARY RESOLUTION FILED CONCURRENTLY WITH THIS CORNER MONUMENTATION RECORD.

SET 1-1/2" ALUMINUM CAP ON A 5/8" X 30" IRON ROD, UP 3", WITH A POST WITH PADDLE PLACED 1' SOUTHWEST OF MONUMENT. THE CAP IS MARKED AS SHOWN BELOW.

THE REFERENCES SET FOR SAID CORNER ARE AS FOLLOWS:

- 1) A 5/8" X 30" IRON ROD WITH A 1-1/2" ALUMINUM CAP, FLUSH, STAMPED "ODOT" BEARS S84°40'06"E, 9.58 FEET.
- 2) A 5/8" X 30" IRON ROD WITH A 1-1/2" ALUMINUM CAP, FLUSH, STAMPED "ODOT" BEARS S32°40'06"W, 8.66 FEET.

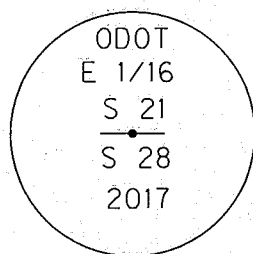

REGISTERED  
PROFESSIONAL  
LAND SURVEYOR

*BEL*

OREGON  
JAN 14, 2003  
BRET N. ELITHORP  
61348

RENEWS: 12/31/2017

**WITNESSES:**

MARK STEWART, CHASE KING

I HEREBY CERTIFY THAT THE ABOVE CORNER POSITION WAS RE-ESTABLISHED AS HEREON DESCRIBED ON APRIL 3, 2017.

OREGON DEPARTMENT OF TRANSPORTATION



**RIGHT OF WAY  
ENGINEERING**

FILED *May 17, 2017*

BAKER COUNTY SURVEYOR

SURVEY NO. *12-13-100*

|         |                         |       |                |
|---------|-------------------------|-------|----------------|
| Section | UNITY RESERVOIR QUARRY  |       |                |
| Highway | DOOLEY MOUNTAIN HIGHWAY |       |                |
| County  | BAKER                   | Scale | NTS            |
| Purpose | QUARRY BOUNDARY         | Date  | APRIL 11, 2017 |