


CERTIFIED RECORD OF LAND CORNER MONUMENTATION

HISTORY OF ORIGINAL CORNER ESTABLISHMENT:
NONE

DIAGRAM

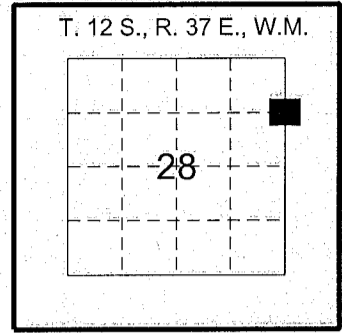

DESCRIPTION OF CORNER EVIDENCE FOUND:
NONE

DESCRIPTION OF MONUMENT AND ACCESSORIES I ESTABLISHED TO PERPETUATE THE ORIGINAL LOCATION OF THIS CORNER:


ESTABLISHED THE CORNER AS SHOWN ON THE RECORD OF SURVEY FOR THE UNITY RESERVOIR QUARRY BOUNDARY RESOLUTION FILED CONCURRENTLY WITH THIS CORNER MONUMENTATION RECORD.

SET 1-1/2" ALUMINUM CAP ON A 5/8" X 30" IRON ROD, UP 5" ABOVE THE GROUND, PLACED MOUND OF STONES AROUND MONUMENT, WITH A POST WITH PADDLE PLACED 1' NORTHWESTERLY OF MONUMENT.

THE CAP IS MARKED AS SHOWN BELOW.

THE REFERENCES SET FOR SAID CORNER ARE AS FOLLOWS:

- 1) A 1/2" X 30" SQUARE IRON ROD WITH A 1-1/2" ALUMINUM CAP, FLUSH, STAMPED "ODOT" BEARS S82°15'12"W, 10.59 FEET.
- 2) A 1/2" X 30" SQUARE IRON ROD WITH A 1-1/2" ALUMINUM CAP, FLUSH, STAMPED "ODOT" BEARS S22°58'29"E, 8.40 FEET.

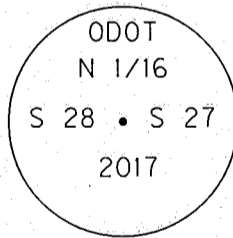

WITNESSES:
MARK STEWART, CHASE KING

I HEREBY CERTIFY THAT THE ABOVE CORNER POSITION WAS RE-ESTABLISHED AS HEREON DESCRIBED ON MARCH 29, 2017.

REGISTERED
PROFESSIONAL
LAND SURVEYOR

OREGON
JAN 14, 2003
BRET. N. ELITHORP
61348

RENEWS: 12/31/2017

OREGON DEPARTMENT OF TRANSPORTATION
**RIGHT OF WAY
ENGINEERING**

FILED May 17, 2017

BAKER COUNTY SURVEYOR

SURVEY NO. 12-37-103

Section	UNITY RESERVOIR QUARRY		
Highway	DOOLEY MOUNTAIN HIGHWAY		
County	BAKER	Scale	NTS
Purpose	QUARRY BOUNDARY	Date	APRIL 11, 2017