

**CERTIFIED RECORD OF LAND CORNER MONUMENTATION**


**HISTORY OF ORIGINAL CORNER ESTABLISHMENT:**

THIS CORNER WAS ORIGINALLY ESTABLISHED BY W.R. GRADON UNDER CONTRACT NO. 409 DATED MAR. 28, 1882.

**SURVEYOR GENERAL LAND OFFICE RECORDS STATE:**

"SET A POST 4 FT LONG, 4 INCHES SQUARE, WITH A MARKED STONE, 12" IN GROUND FOR THE COR. TO SECTIONS 27,28,33,34 MARKED T12S S27 ON NE, R37E S34 ON SE S33 ON SW AND S28 ON NW FACES, WITH 1 NOTCH ON S. AND 3 NOTCHES ON E. EDGES. DUG PITS 18"X18"X12" IN EACH SECTION, 5.5 FT. DIST. AND RAISED A MOUND OF EARTH 2 FT., 4.5 FT. BASE DUG PITS ALONGSIDE."

**DIAGRAM**

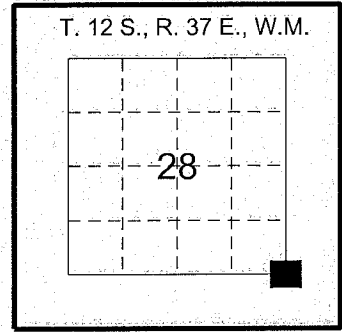

V-13

**DESCRIPTION OF CORNER EVIDENCE FOUND:**

NONE

**DESCRIPTION OF MONUMENT AND ACCESSORIES I ESTABLISHED TO PERPETUATE THE ORIGINAL LOCATION OF THIS CORNER:**


RE-ESTABLISHED THE CORNER BY DOUBLE PROPORTION BY HOLDING THE REMONUMENTED LOCATION OF THE INTERSECTION OF THE CENTER OF ROUSE LANE WITH A NORTH-SOUTH FENCE LINE AT THE NORTH QUARTER CORNER OF SECTION 32 AND A FENCE CORNER AT THE SOUTHEAST CORNER OF SECTION 27 IN THE EAST-WEST DIRECTION, AND HOLDING THE CALCULATED POSITION OF THE SOUTHEAST CORNER OF SECTION 33 AND THE REMONUMENTED STONE FOUND AT THE EAST QUARTER CORNER OF SECTION 28, IN THE NORTH-SOUTH DIRECTION. THE SOUTHEAST CORNER OF SECTION 33 WAS CALCULATED, AS SHOWN ON THE RECORD OF SURVEY FOR THE UNITY RESERVOIR QUARRY BOUNDARY RESOLUTION FILED CONCURRENTLY WITH THIS CORNER MONUMENTATION RECORD.

SET 3-1/4" ALUMINUM CAP ON A 5/8"X30" IRON ROD, UP 6", WITH POST AND PADDLE 1 FOOT NORTHERLY.

THE CAP IS MARKED AS SHOWN BELOW.

**THE REFERENCES SET FOR SAID CORNER ARE AS FOLLOWS:**

- 1) A 5/8" X 30" SMOOTH IRON ROD WITH A 1-1/2" ALUMINUM CAP, FLUSH, STAMPED "ODOT" BEARS N01°57'22"E, 10.61 FEET.
- 2) A 5/8" X 30" SMOOTH IRON ROD WITH A 1-1/2" ALUMINUM CAP, FLUSH, STAMPED "ODOT" BEARS S78°08'40"E, 11.12 FEET.
- 3) A 5/8" X 30" SMOOTH IRON ROD WITH A 1-1/2" ALUMINUM CAP, FLUSH, STAMPED "ODOT" BEARS S07°58'08"W, 10.68 FEET.
- 4) A 5/8" X 30" SMOOTH IRON ROD WITH A 1-1/2" ALUMINUM CAP, FLUSH, STAMPED "ODOT" BEARS N77°59'02"W, 11.85 FEET.

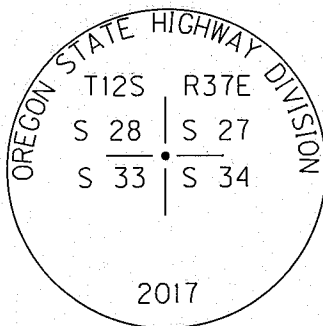

**WITNESSES:**

MARK STEWART, CHASE KING

I HEREBY CERTIFY THAT THE ABOVE CORNER POSITION WAS RE-ESTABLISHED AS HEREON DESCRIBED ON MARCH 29, 2017.

REGISTERED  
PROFESSIONAL  
LAND SURVEYOR

*B. N. Elithorp*

OREGON  
JAN 14, 2003  
BRET N. ELITHORP  
61348

RENEWS: 12/31/2017

OREGON DEPARTMENT OF TRANSPORTATION



FILED May 17, 2017

BAKER COUNTY SURVEYOR

SURVEY NO. 12-37-109

Section	UNITY RESEVOIR QUARRY		
Highway	DOOLEY MOUNTAIN HIGHWAY		
County	BAKER	Scale	NTS
Purpose	QUARRY BOUNDARY	Date	APRIL 11, 2017