


CERTIFIED RECORD OF LAND CORNER MONUMENTATION

HISTORY OF ORIGINAL CORNER ESTABLISHMENT:
NONE

DIAGRAM

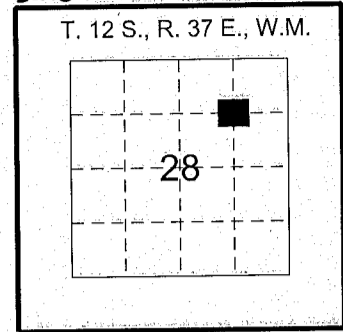

S-12

DESCRIPTION OF CORNER EVIDENCE FOUND:
NONE

DESCRIPTION OF MONUMENT AND ACCESSORIES ESTABLISHED TO PERPETUATE THE ORIGINAL LOCATION OF THIS CORNER:


ESTABLISHED THE CORNER AS SHOWN ON THE RECORD OF SURVEY FOR THE UNITY RESERVOIR QUARRY BOUNDARY RESOLUTION FILED CONCURRENTLY WITH THIS CORNER MONUMENTATION RECORD.

SET 1-1/2" ALUMINUM CAP ON A 5/8" X 30" IRON ROD, UP 2" ABOVE THE GROUND, WITH A POST WITH PADDLE PLACED 1' NORTHEAST OF MONUMENT.

THE CAP IS MARKED AS SHOWN BELOW.

THE REFERENCES SET FOR SAID CORNER ARE AS FOLLOWS:

- 1) A 5/8" X 30" IRON ROD WITH A 1-1/2" ALUMINUM CAP, FLUSH, STAMPED "ODOT" BEARS N19°16'12"W, 15.02 FEET.
- 2) A 5/8" X 30" IRON ROD WITH A 1-1/2" ALUMINUM CAP, FLUSH, STAMPED "ODOT" BEARS S84°08'58"E, 11.54 FEET.

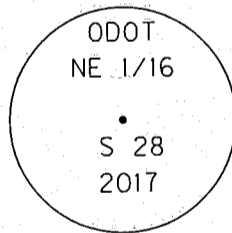

REGISTERED
PROFESSIONAL
LAND SURVEYOR

BQC

OREGON
JAN 14, 2003
BRET N. ELITHORP
61348

RENEWS: 12/31/2017

WITNESSES:
MARK STEWART, CHASE KING

I HEREBY CERTIFY THAT THE ABOVE CORNER POSITION WAS RE-ESTABLISHED AS HEREON DESCRIBED ON MARCH 28, 2017.

OREGON DEPARTMENT OF TRANSPORTATION

**RIGHT OF WAY
ENGINEERING**

FILED May 17, 2017

BAKER COUNTY SURVEYOR

SURVEY NO. 12-37-102

Section	UNITY RESERVOIR QUARRY		
Highway	DOOLEY MOUNTAIN HIGHWAY		
County	BAKER	Scale	NTS
Purpose	QUARRY BOUNDARY	Date	APRIL 11, 2017